


T. 8S. R. 46E. W.M.

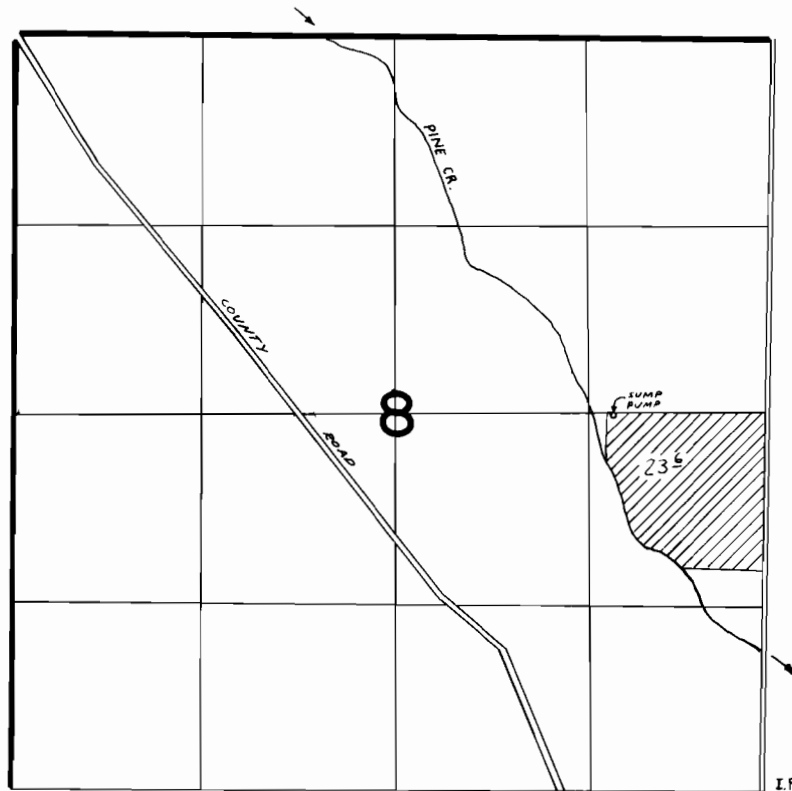

PUMP LOC. 10'S & 1050' W FROM E 1/4 COR SEC 8

**FINAL PROOF SURVEY**  
UNDER

Application No. G-6978. Permit No. G-6486.  
IN NAME OF

.....WALTER & LOIS ROBINSON.....

Surveyed 5-31-1978, by R. BARWIN