


T.30S. R.6W. W.M.

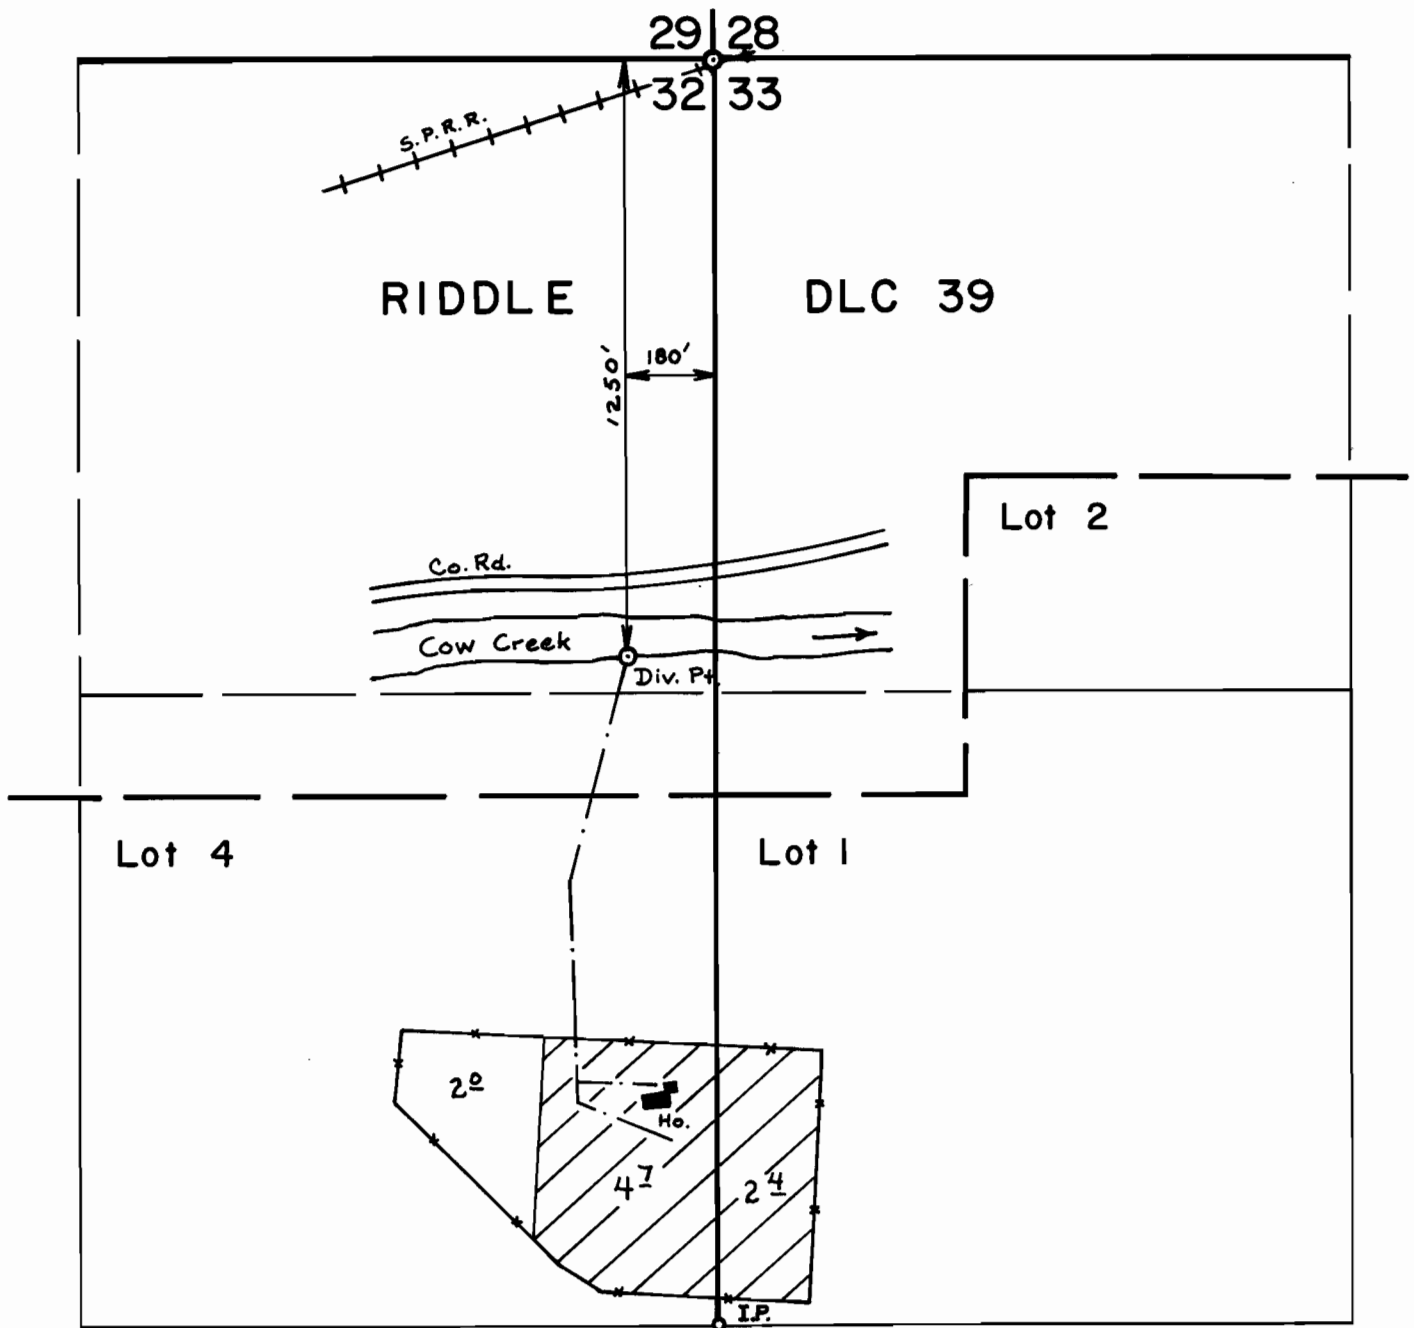

SCALE: 1" = 400'

FINAL PROOF SURVEY
UNDER

Application No. 50470 Permit No. 38118
IN NAME OF

OSCAR & IRMA LEE WADDINGTON

Surveyed Feb. 10 1978, by D. Sparks