


T.26S. R.3W. W.M.

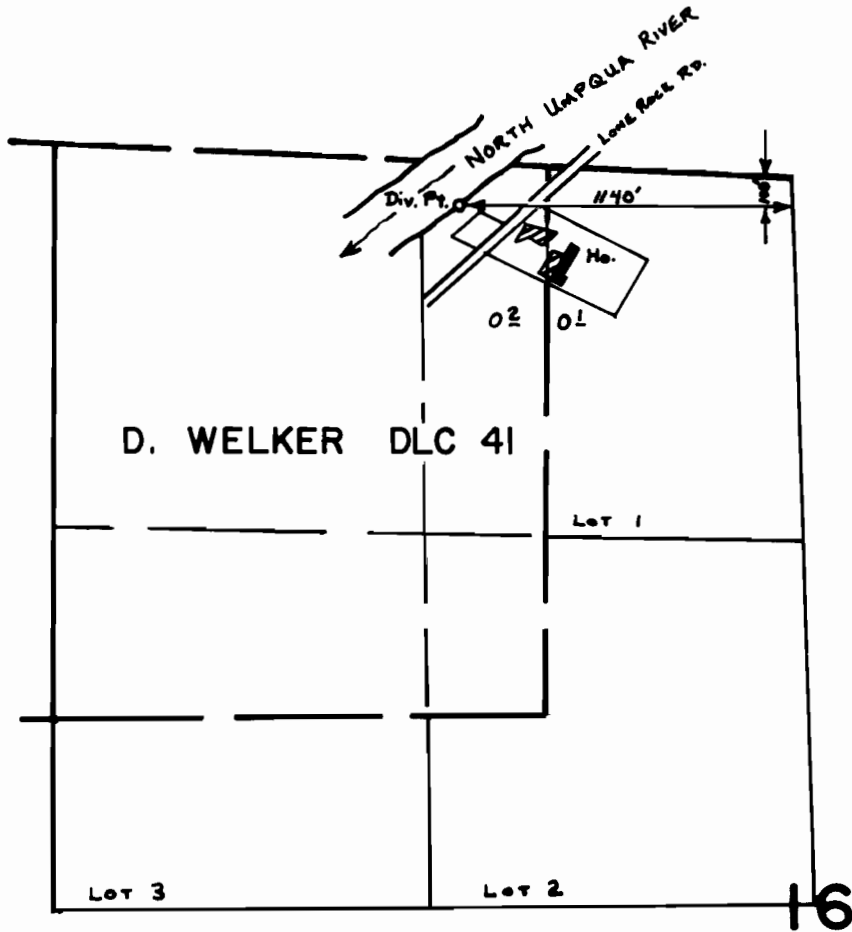

SCALE: 1" = 660'

FINAL PROOF SURVEY
UNDER

Application No. 54566 Permit No. 40945
IN NAME OF

GREGOR WADSWORTH

Surveyed Oct. 24, 1977, by D. Sparks