


T.30S. R.3W., W.M.

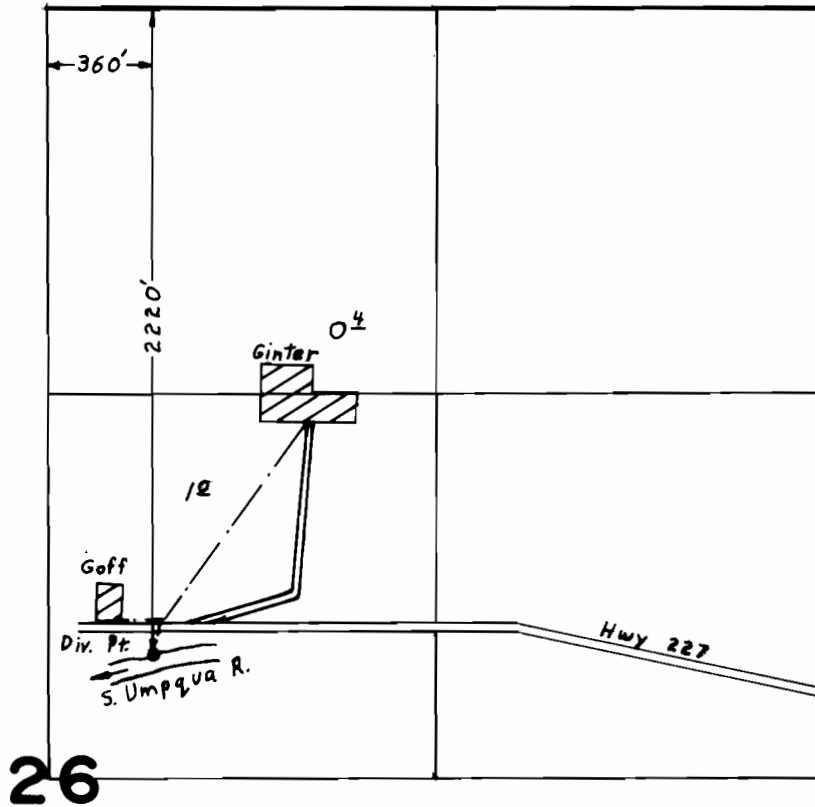

Scale : 1" = 660'

FINAL PROOF SURVEY UNDER

Application No. 47258.. Permit No. 35396...
IN NAME OF

.....RUPERT & RUTH HUNT.....

Surveyed MAY 19... 1977, by D.M. NORBY.....