


T.26S. R.7W. W.M.

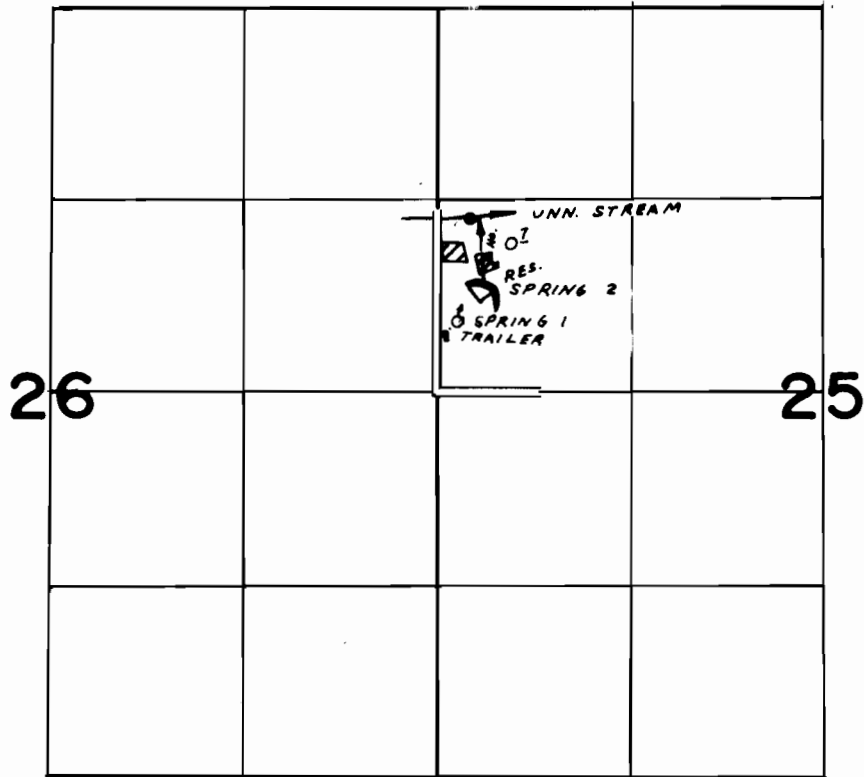

DIV. PT. LOC. 1210'N & 220'E, SPRING 1 LOC. 490'N. & 140'E.; SPRING 2 LOC. 690'N. & 300'E.; ALL FROM W 1/4 COR. SEC. 25.

**FINAL PROOF SURVEY**  
UNDER

Application No. 47691..... Permit No. 36339.....  
IN NAME OF

*Melvin Wharton & Charles Buletti*

Surveyed APR. 9. 1976., by L.H. NUNN.....