


T. 22 & 23 S., R. 6 & 5 W., W.M.

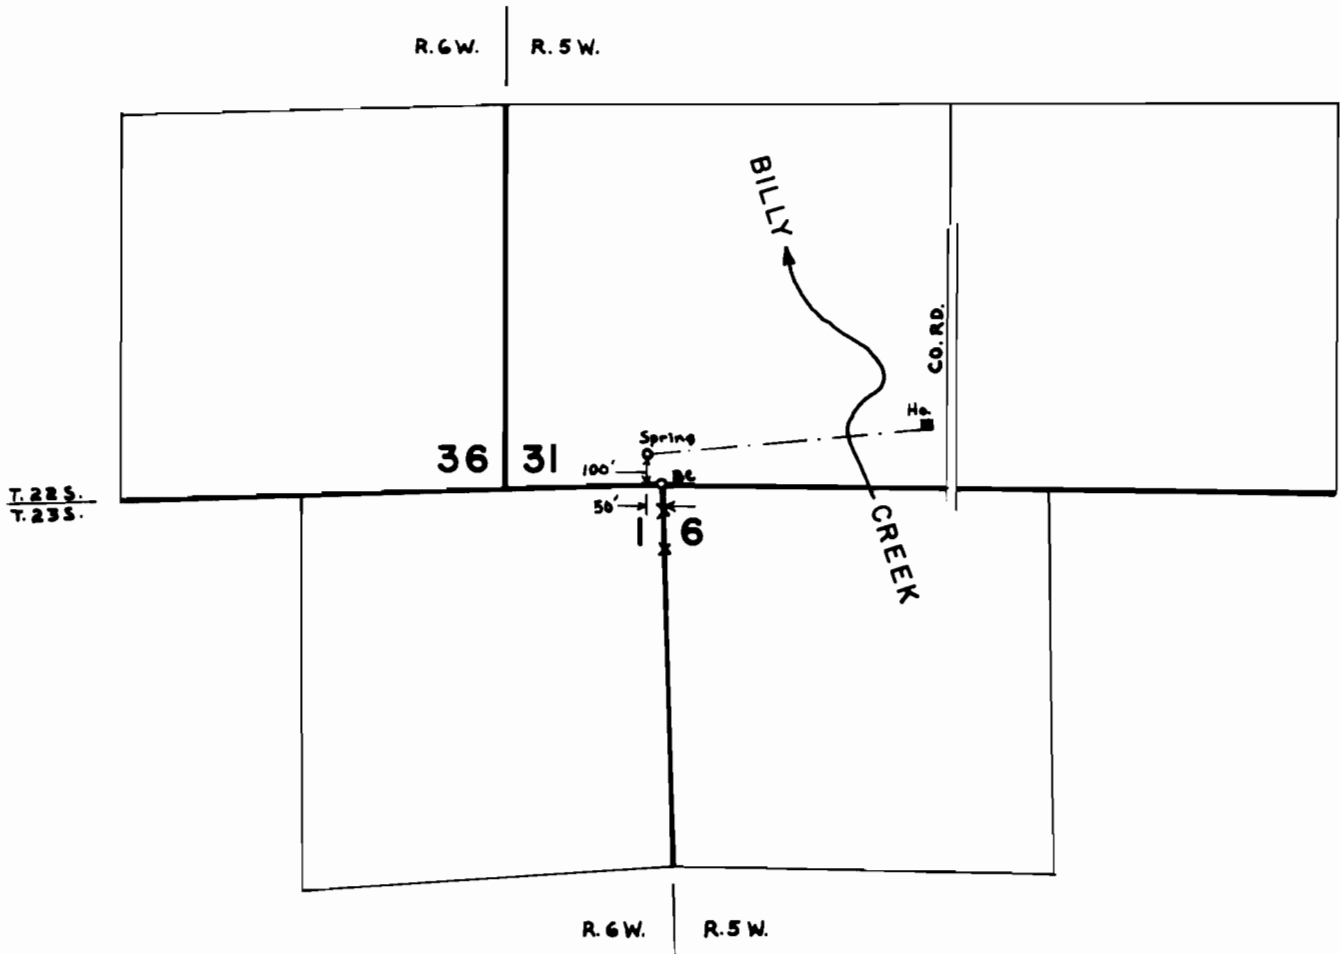

SCALE: 1" = 660'

FINAL PROOF SURVEY UNDER

Application No. 55291. Permit No. 41482.
IN NAME OF

MARY MARAGARET BALDWIN

Surveyed SEPT. 25 1978, by D.R. HENRY