


T. 25S. R. 7W. W.M

Sec. 8

SE 1/4 NW 1/4

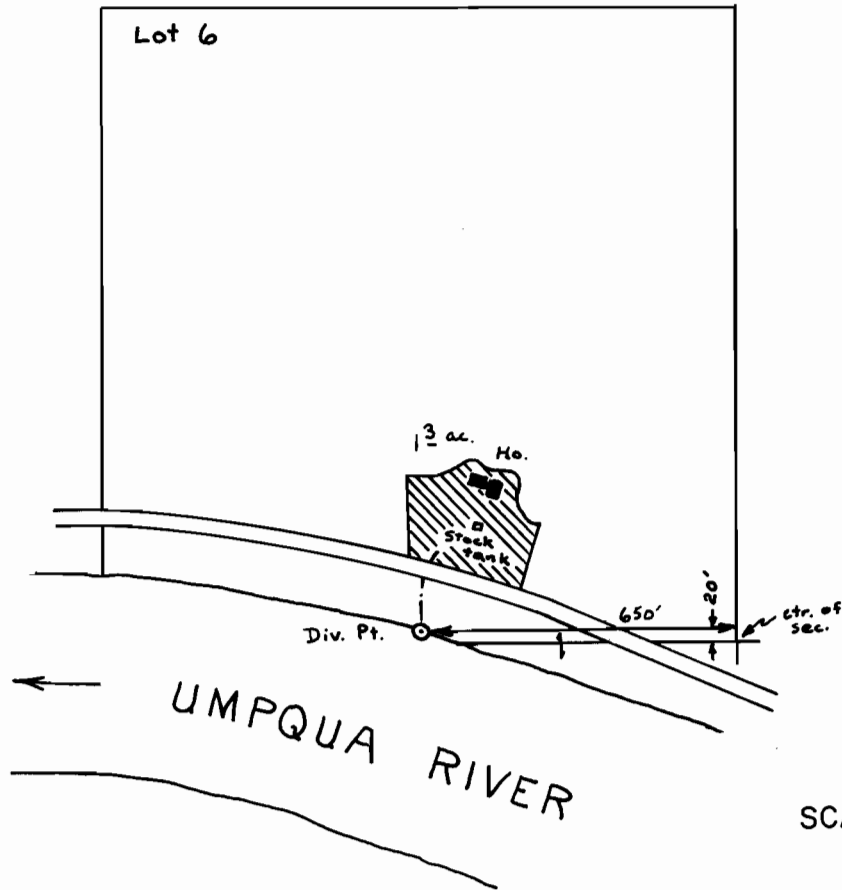

SCALE: 1" = 400'

**FINAL PROOF SURVEY**  
UNDER

Application No. 50502 Permit No. 38135  
IN NAME OF

FRANK M. NIELSEN

Surveyed Oct. 30 1978, by S. Donaldson.