


T.27S. R.3W. W.M.

Sec. 14

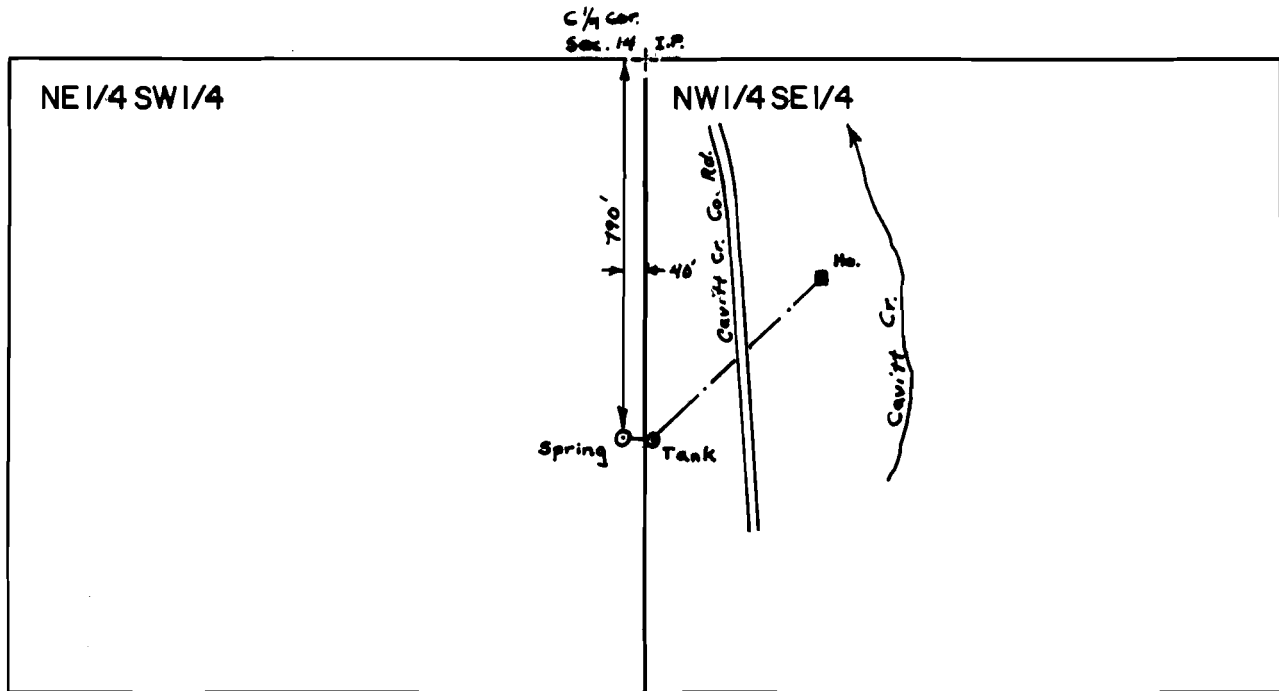

SCALE : 1" = 400'

FINAL PROOF SURVEY
UNDER

Application No. 56780 Permit No. 42582
IN NAME OF

VARIAN P. WHITE

Surveyed May 5 1978, by D. Sparks