


T.26S. R.3W. W.M.

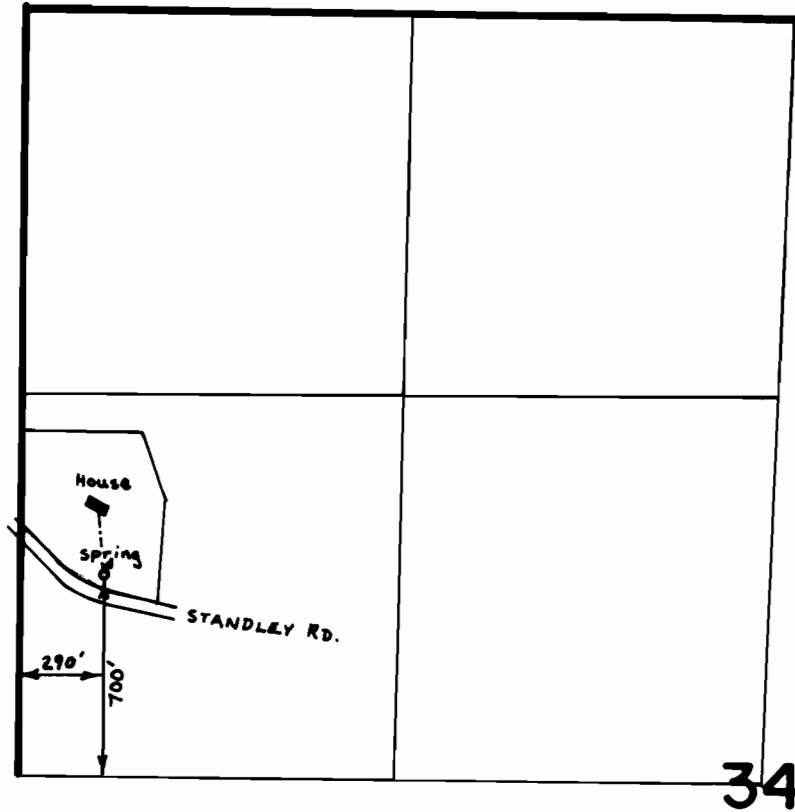

SCALE: 1" = 660'

**FINAL PROOF SURVEY**  
UNDER

Application No. 54533 Permit No. 40900  
IN NAME OF

THOMAS ALAN GOODEMOTE

Surveyed Oct. 24 1977., by D. Sparks

*JD*