


T.29S. R.4W. W.M.

Sec. 14

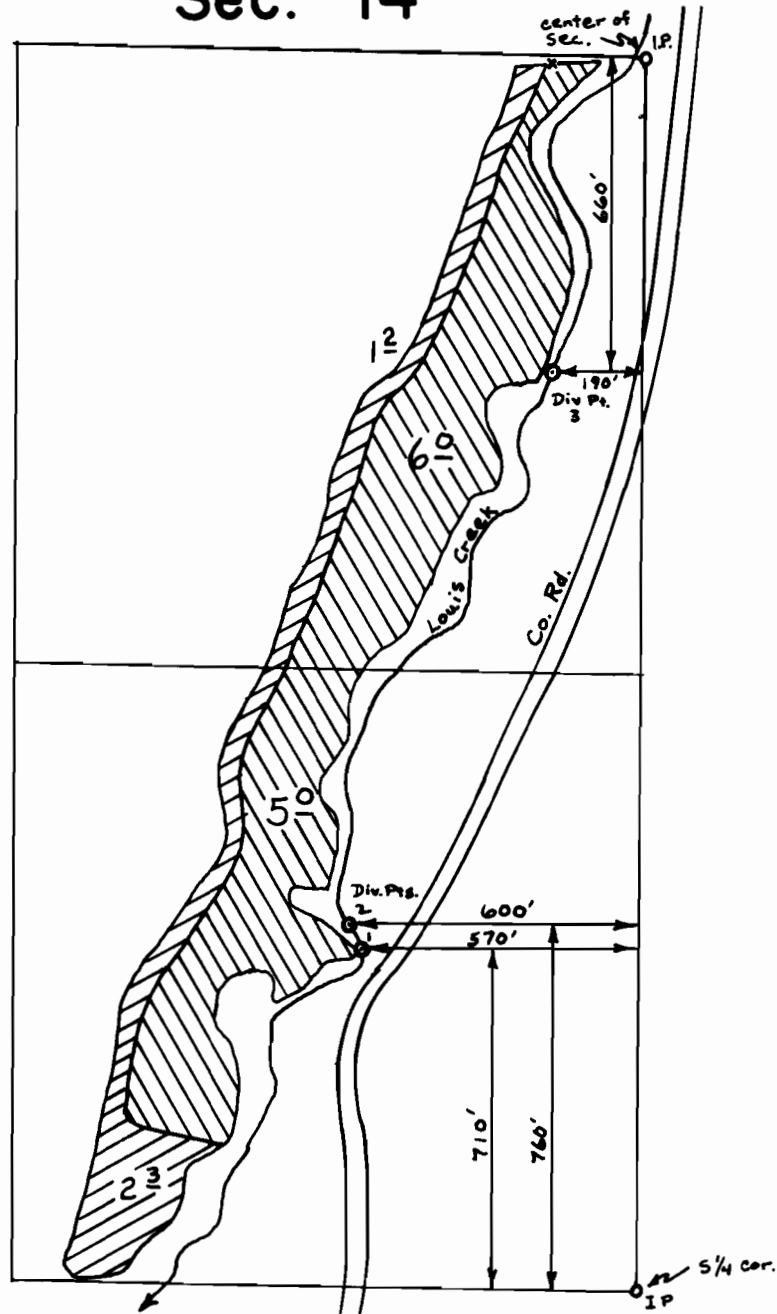

SCALE: 1" = 400'

**FINAL PROOF SURVEY**  
UNDER

 Permit # 3544  
 Permit # 33250

Application No. 44456 Permit No. 33250  
IN NAME OF

LUTHER H. PRUETT

Surveyed Jan. 20 1978 by D. Sparks  
Nov. 8 1978, by S. Donaldson