


# T.26S. R.6 W., W.M.

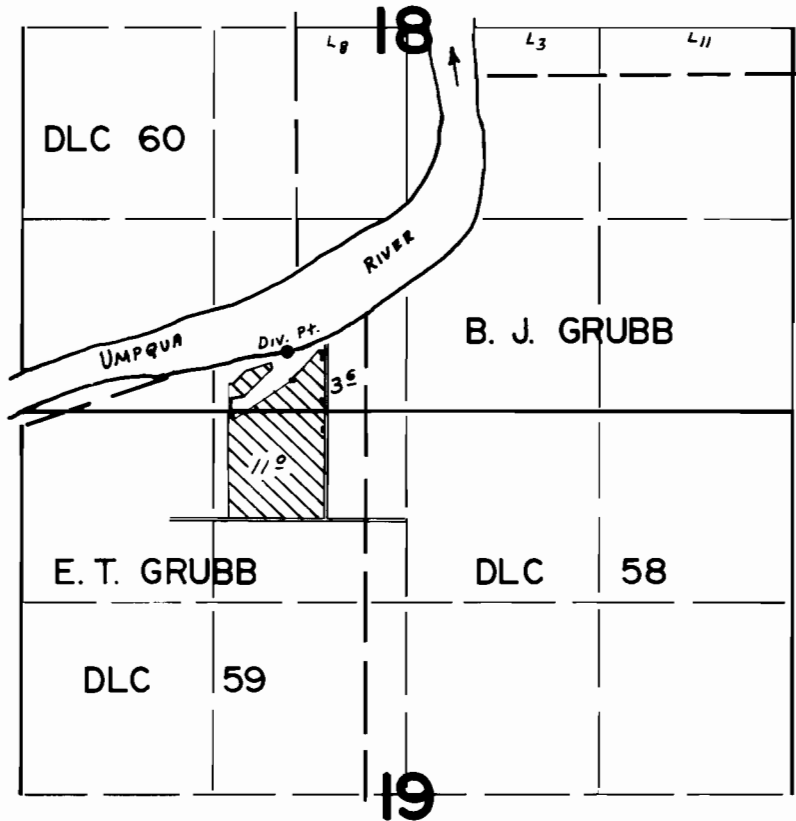

Div. Pt. Loc. 400' N. & 1820' E. FROM S. W. COR. SEC 18

## FINAL PROOF SURVEY UNDER

Application No. 26354.. Permit No. 20675.....  
IN NAME OF

..... LOIS & HARRY WESLEY .....

Surveyed JUNE 9... 1956., by C. O. BARTELS.....