


T.24S. R.5W. W.M.

Sec. 4

SW 1/4 NE 1/4

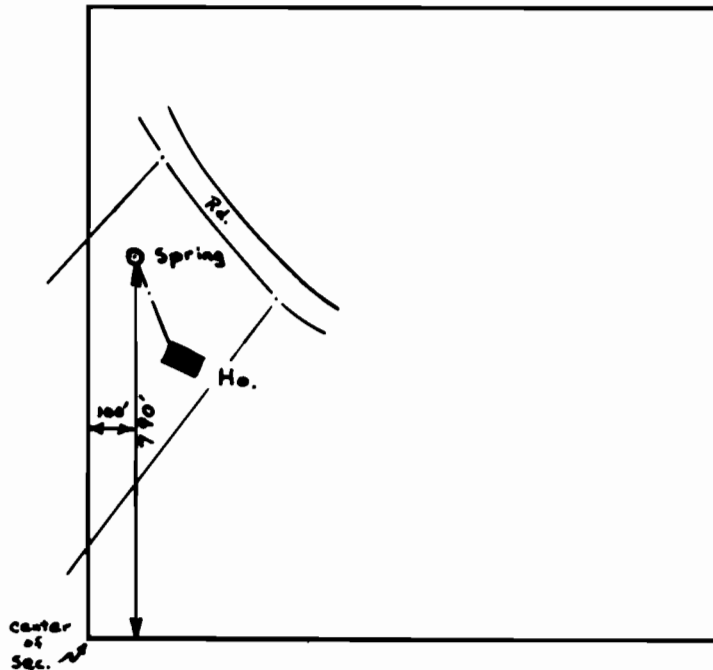

SCALE : 1" = 400'

FINAL PROOF SURVEY
UNDER

Application No. 54651 Permit No. 41009
IN NAME OF

JOSEPH J. & JAYNE E. BAKO

Surveyed March 15 1978, by D. Sparks

1/24/78 Cr
10/1/78 Cr