


T.27S. R.6W. W.M.

Sec. 9

N 1/2 SE 1/4

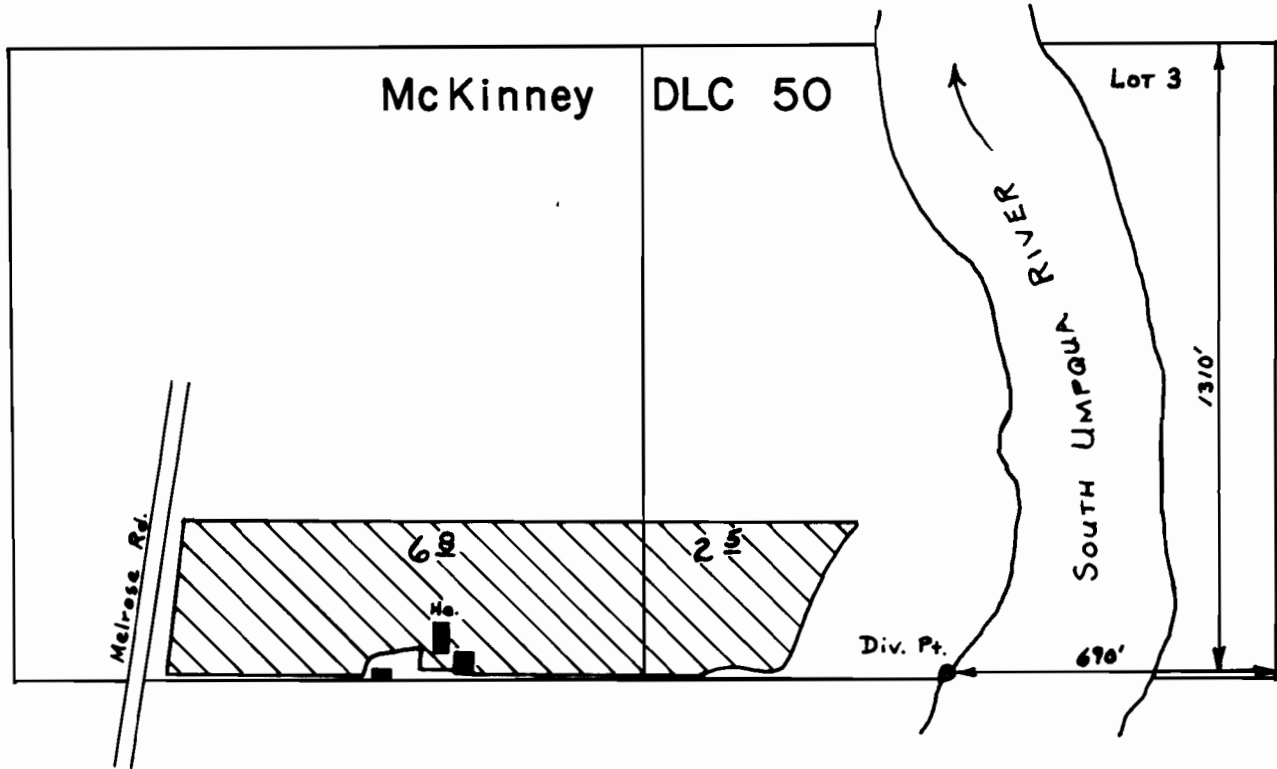

SCALE: 1" = 400'

FINAL PROOF SURVEY
UNDER

Application No. 50036 Permit No. 37616
IN NAME OF

ELVIN V. WOODS

Surveyed March 2, 1978, by D. Sparks