


T. 28 & 29 S., R. 4 W., W.M.

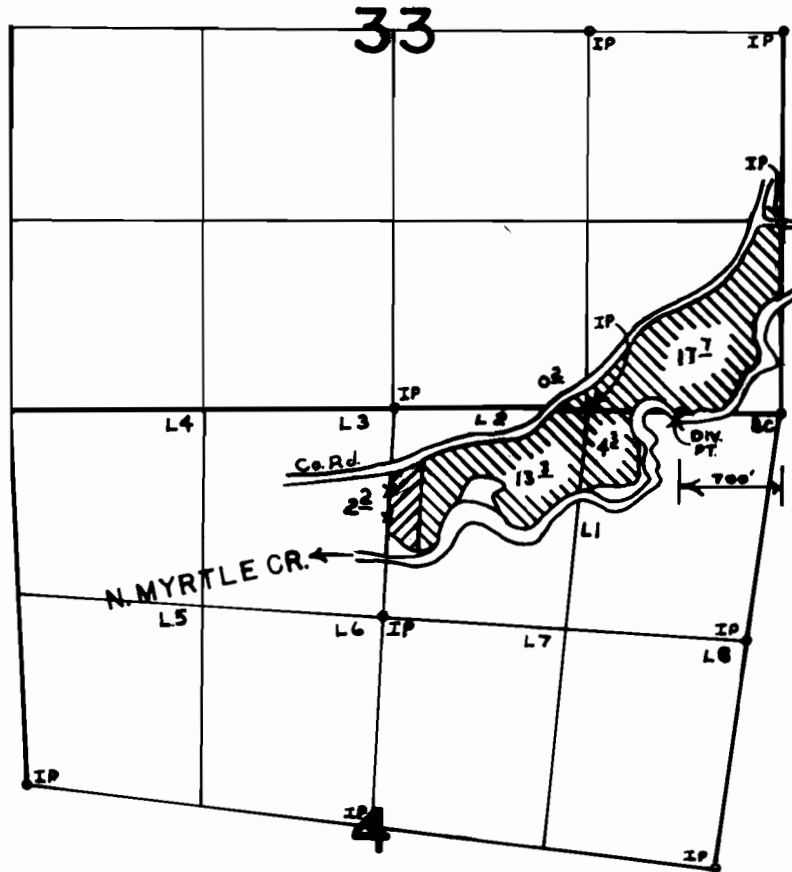

FINAL PROOF SURVEY
UNDER

Application No. 48699 Permit No. 36512
IN NAME OF

DELBERT B. BLANCHARD

Surveyed SEPT. 29 1977, by D.W. SPARKS