


T. 23S. R. 31E. W.M.

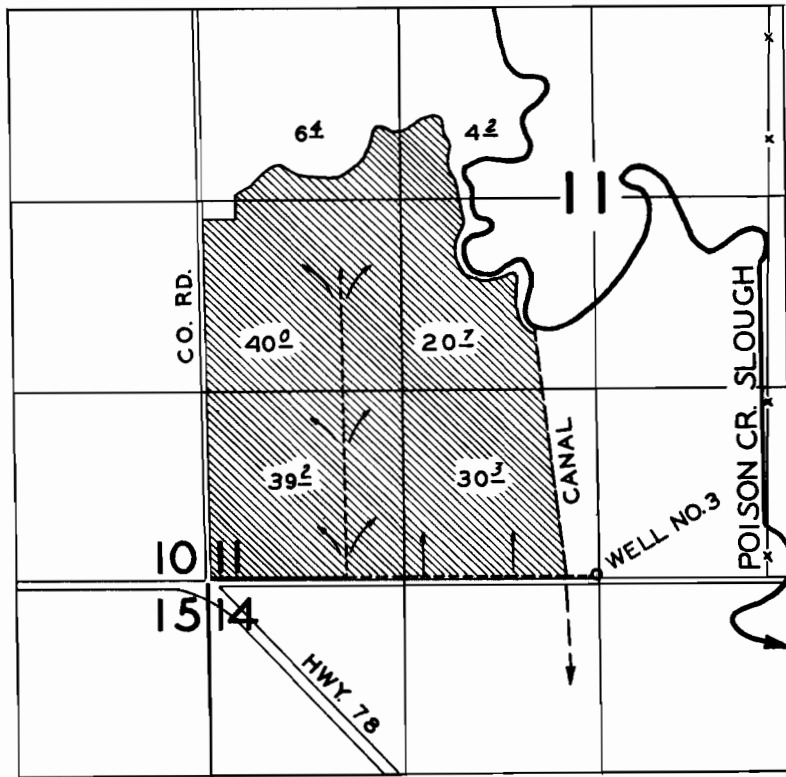

FINAL PROOF SURVEY
UNDER

Application No. G.299 Permit No. G.297
IN NAME OF

RILEY & SEWELL

Surveyed OCT. 26, 1960, by C. O. BARTELS