


G-4963
48885

T.40 & 41S. R.1E. W.M.

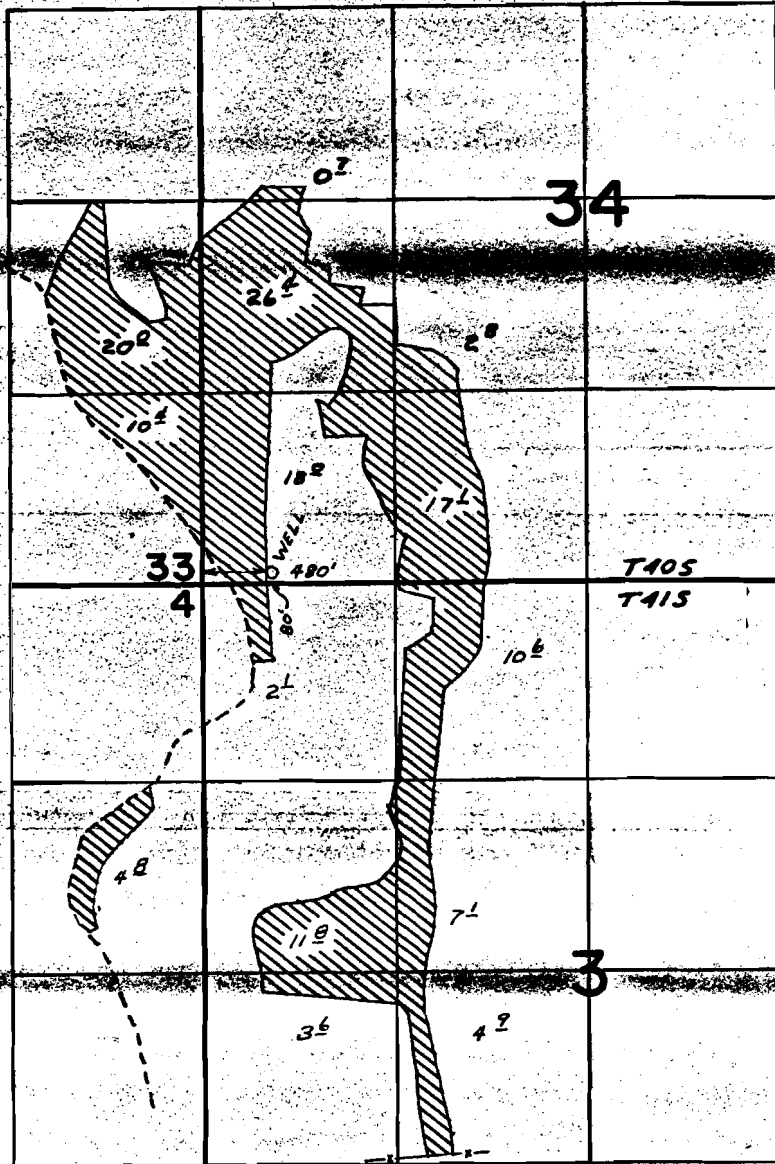

Foot River wells

FINAL PROOF SURVEY UNDER

Application No. G-5744. Permit No. G-4963.
IN NAME OF

CHARLES G. DUNCAN

Surveyed APR. 29, 1976, by J. H. NUNN