


41423  
48886

# T.39S. R.8&9E., W.M.

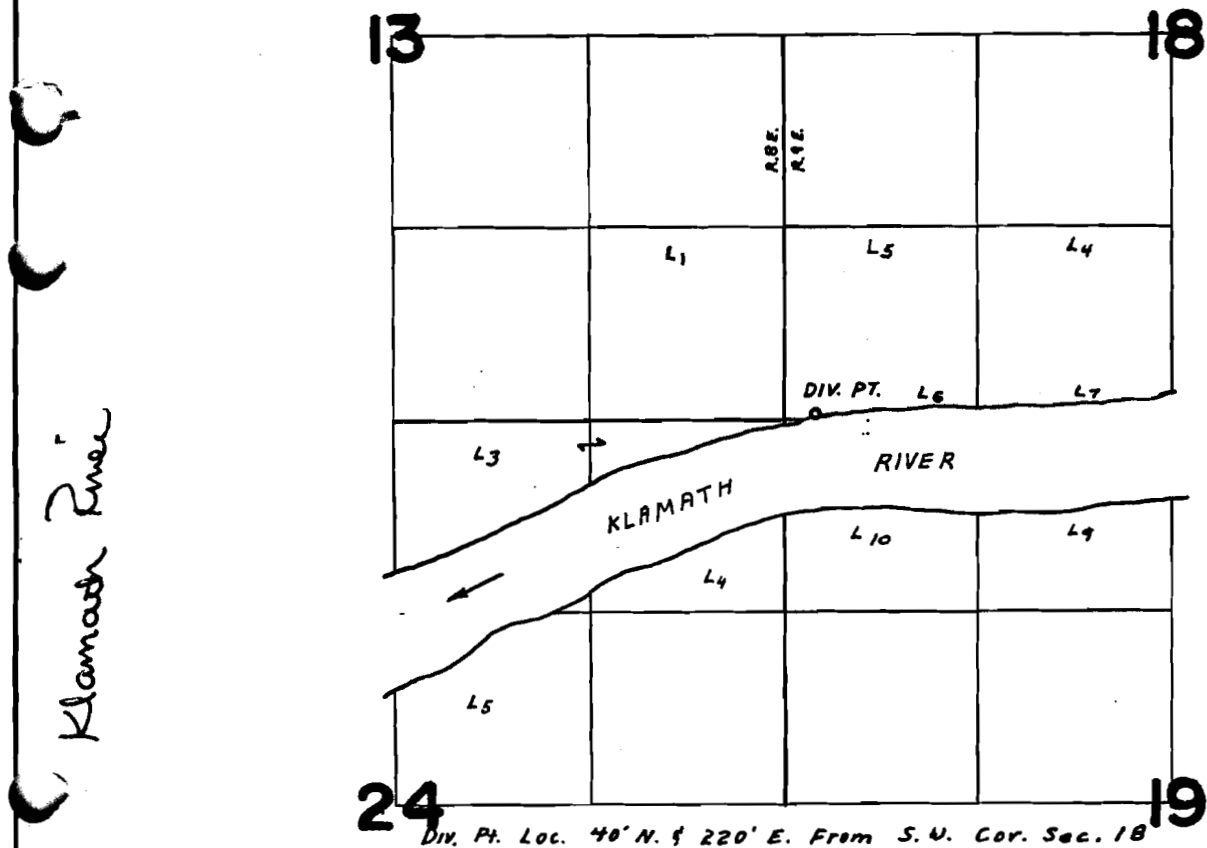

## FINAL PROOF SURVEY UNDER

55267  
Application No. 55912... Permit No. 41423 42358  
IN NAME OF

WEYERHAEUSER CO.

Surveyed JUL 27 1978, by S.P. APPLGATE