


42358
48887

T.39S. R.88&9E., W.M.

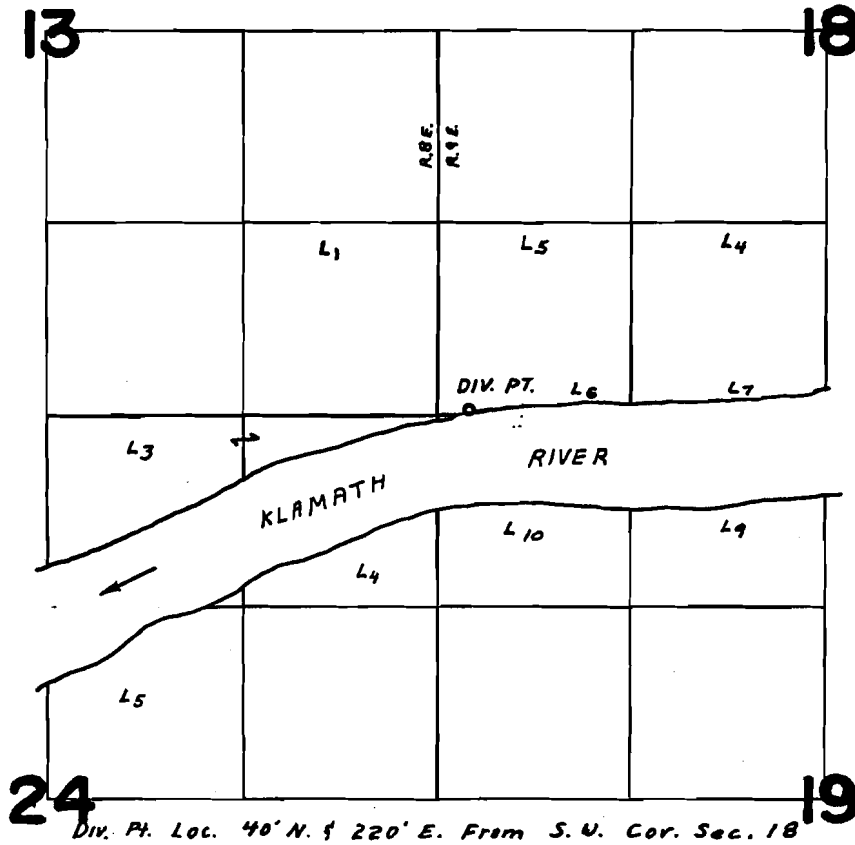

Klamath River

FINAL PROOF SURVEY UNDER

55267
Application No. 55912... Permit No. 42358
IN NAME OF

WEYERHAEUSER CO.

Surveyed JUL. 27. 1978. by S. P. APPLGATE