


T.17S.R.1W.W.M.

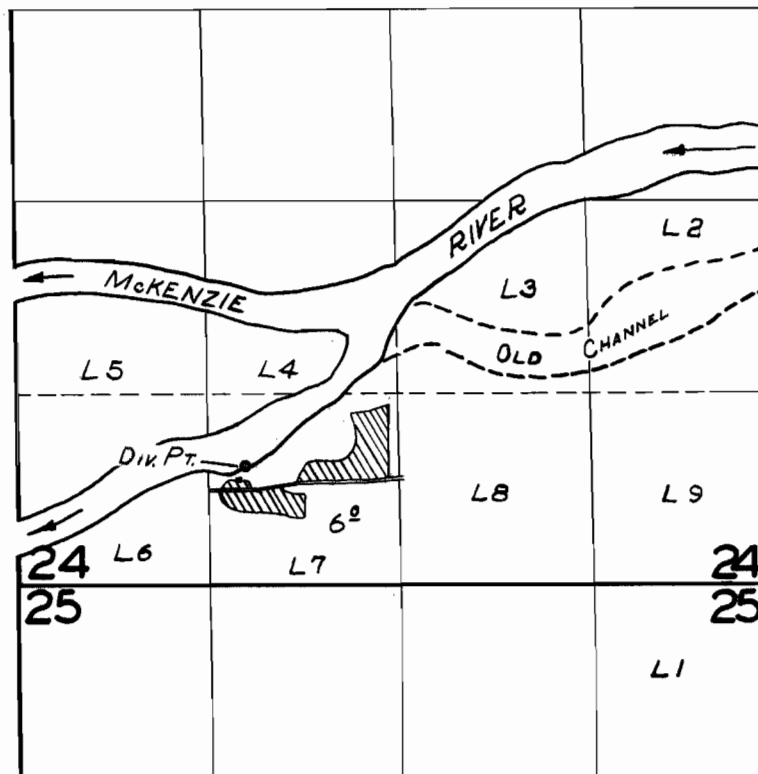

FINAL PROOF SURVEY
UNDER

Application No. 33907. Permit No. 26713.
IN NAME OF

B. W. BOND

Surveyed Mar. 24 1961, by C. Q. BARTELS.