


T. 7S. R. 1W. W.M.

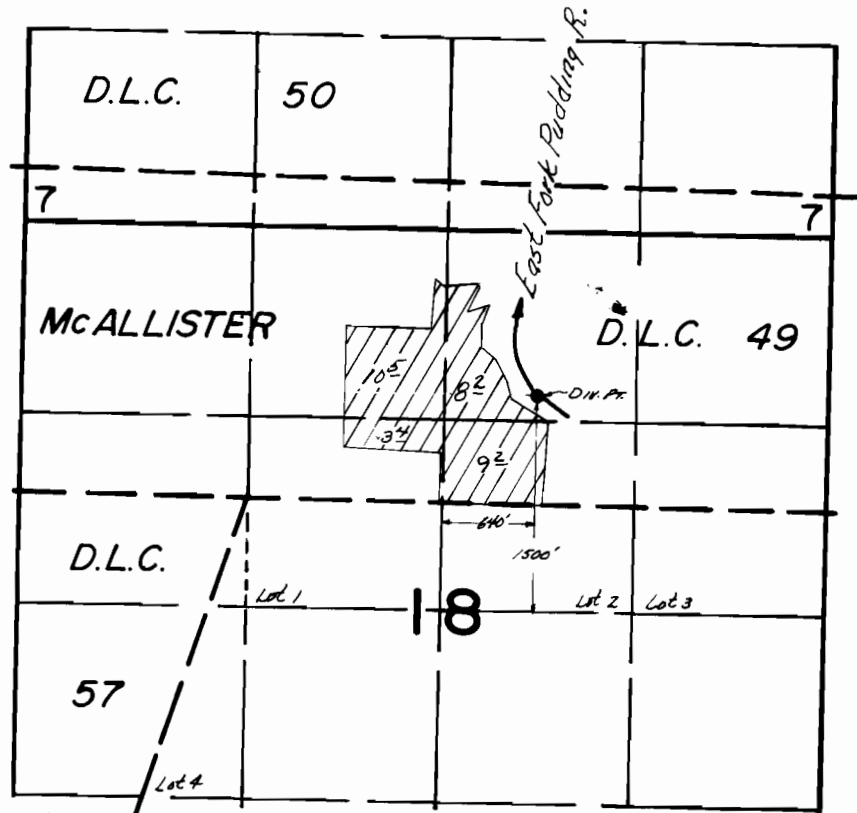

FINAL PROOF SURVEY UNDER

Application No. 39750. Permit No. 29564...
IN NAME OF

ALZADE GASH

Surveyed July 2, 1968, by L. E. GOULD