


# T.4S. R.2W.W.M.

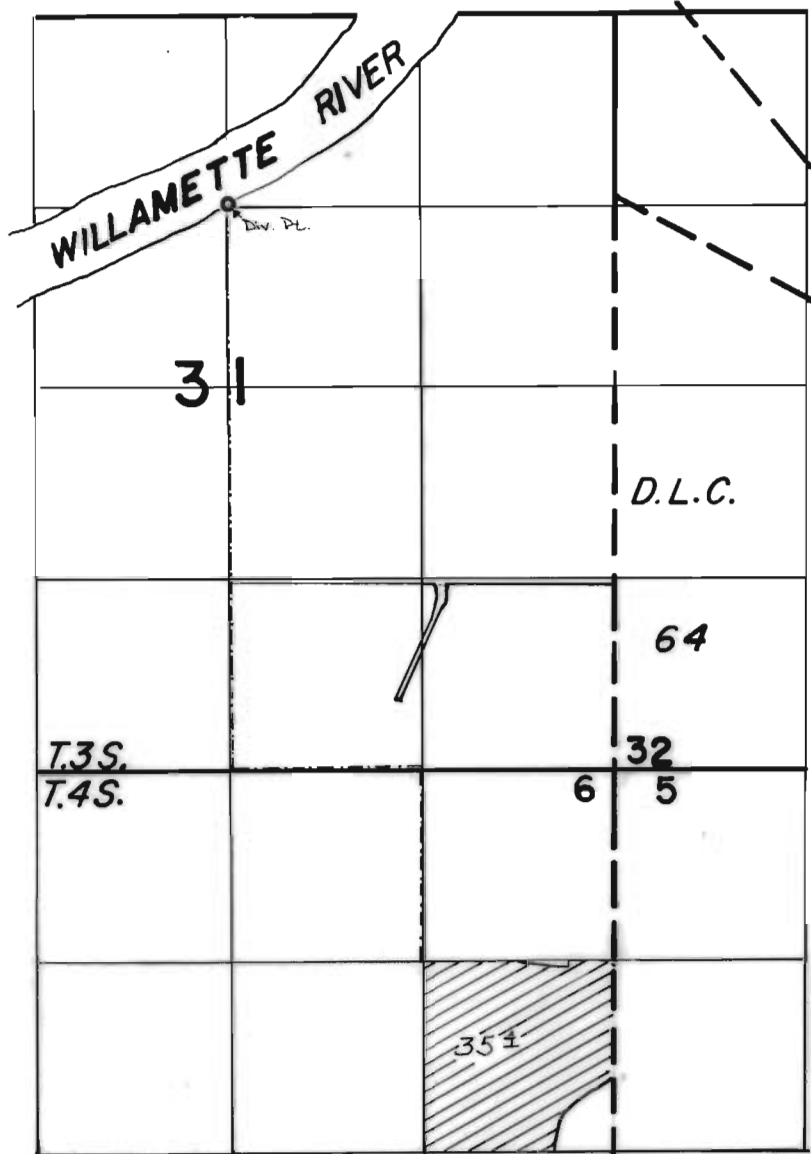

Div. Pt. Loc. - 1320' N + 20' E from C<sup>1</sup>/<sub>4</sub> Cor. Sec. 31

## FINAL PROOF SURVEY UNDER

Application No. 52717... Permit No. 39830...  
IN NAME OF

.....**JOHN WILLIAM NIEHUS**.....

Surveyed July 5, 1978, by R. G. Mucken.....