


T. 6S.R.3W. W.M.

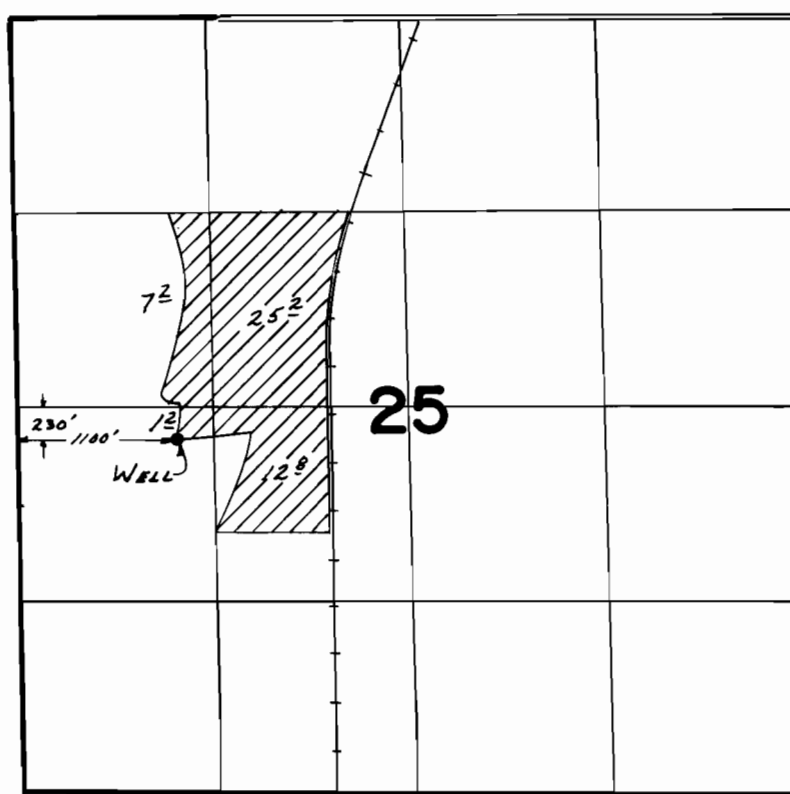

FINAL PROOF SURVEY UNDER

Application No. G-6905 Permit No. G-6431...
IN NAME OF

Mary E. Petzel

Surveyed April 28 1978, by R.G. Mucken....