T. 7S. R. 1W. W.M.

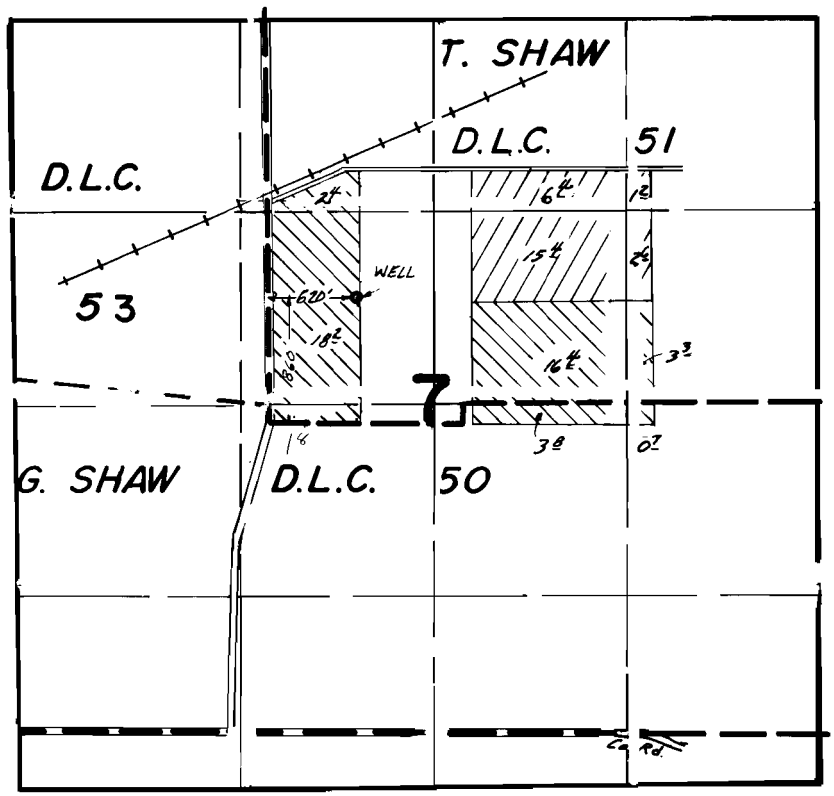

AD lines probably wrong

FINAL PROOF SURVEY
UNDER

G-7222 G-6641
Application No. G-8016 Permit No. G-7422
IN NAME OF

Fred Scharer

Surveyed July 3 1978, by R.G. Mucken
Sept. 6 1979 " C.R. RODRIGUEZ

DFN-1LL-35 6RR.