


T.7S.R.IW.W.M.

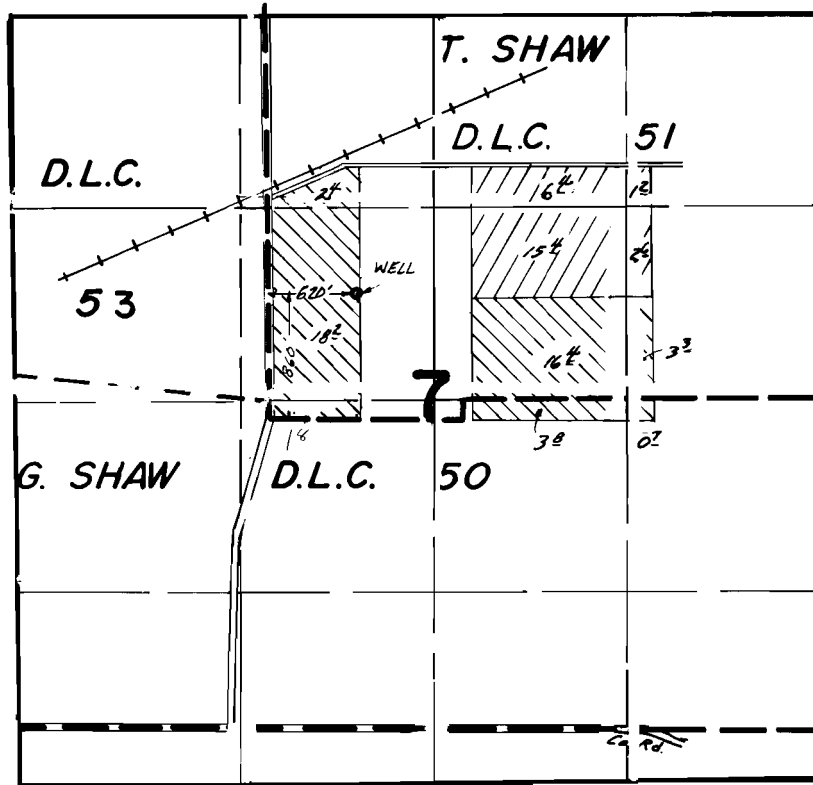

AD lines probably wrong

FINAL PROOF SURVEY UNDER

Application No. **G-7222** Permit No. **G-6641**
G-8016 Permit No. **G-7422**
 IN NAME OF

Fred Scharer

Surveyed July 3, 1978, by R.G. Mucken
 Sept. 6, 1979, C.R. RODRIGUEZ