


T.19S.R.45E.W.M.

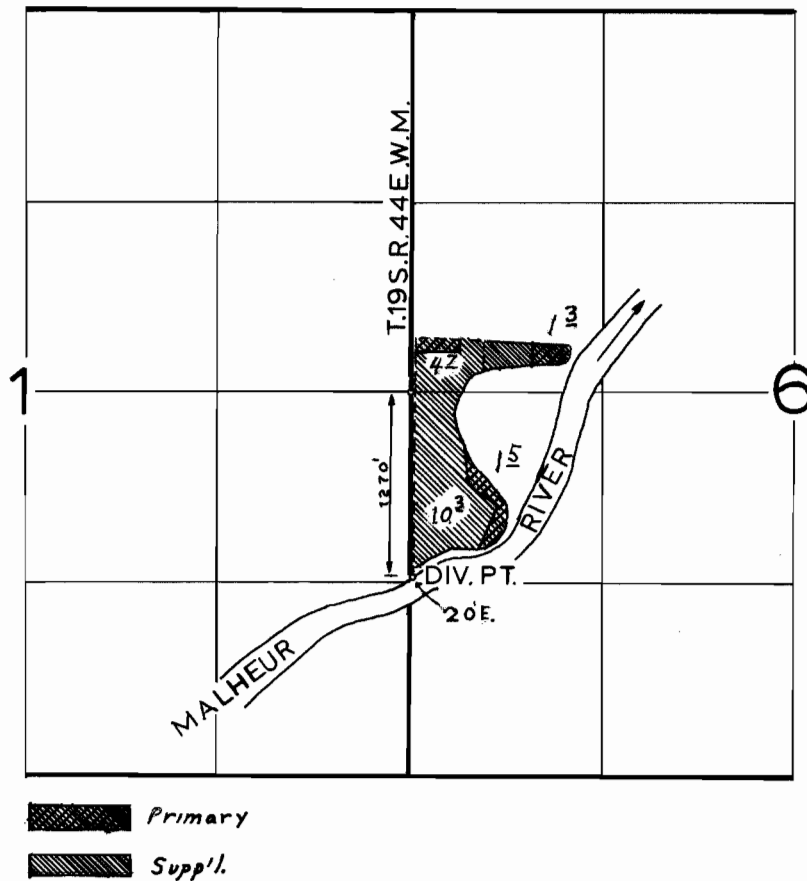

FINAL PROOF SURVEY UNDER

Application No. 42895... Permit No. 32057...
IN NAME OF

Arthur Dunn

Surveyed MARCH 18 1968., by E. E. L. F. E. R. I. N. G.