


T. 4 N. R. 27 E. W. M.

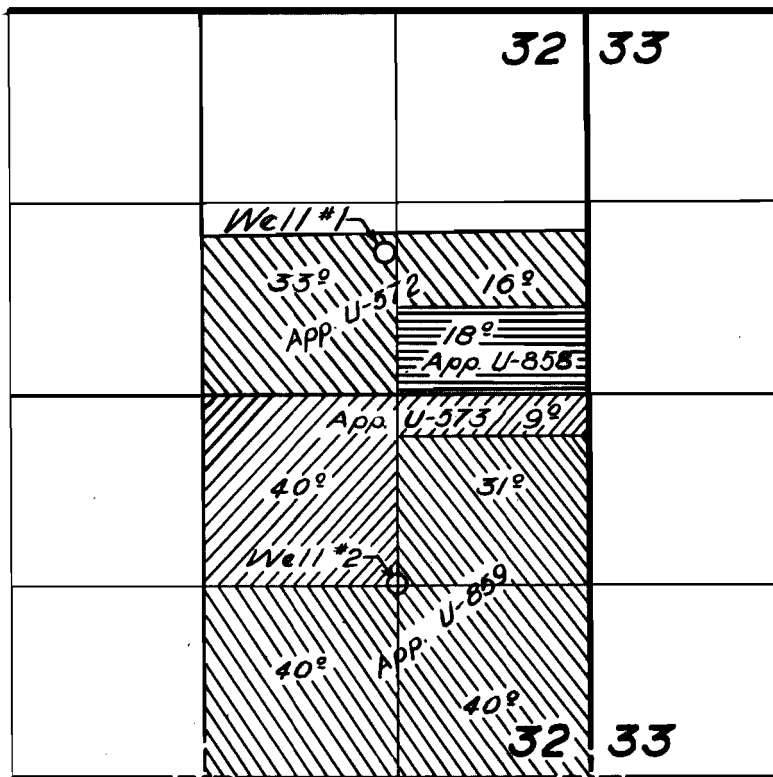

FINAL PROOF SURVEY

UNDER

U-572, U-573

U-523, U-524

Application No. U-858, U-859 Permit No. U-750, U-751

IN NAME OF

ROY GAIL & GEORGIA BELL HOLZAPFEL

Surveyed 13 Apr. 1955, by T. Jones
May 18 1956 C. Wheeler

1955-Z