


T.2N.R.14E.W.M.

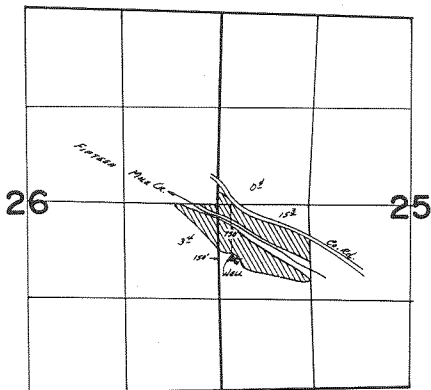

FINAL PROOF SURVEY
UNDER

Application No. G-8156. Permit No. G-7516...
IN NAME OF

JOHNSON BROTHERS.....

Surveyed March 28 1978., by L.H.Nunn.....