


# T. 1 S., R. 3 W., W.M.

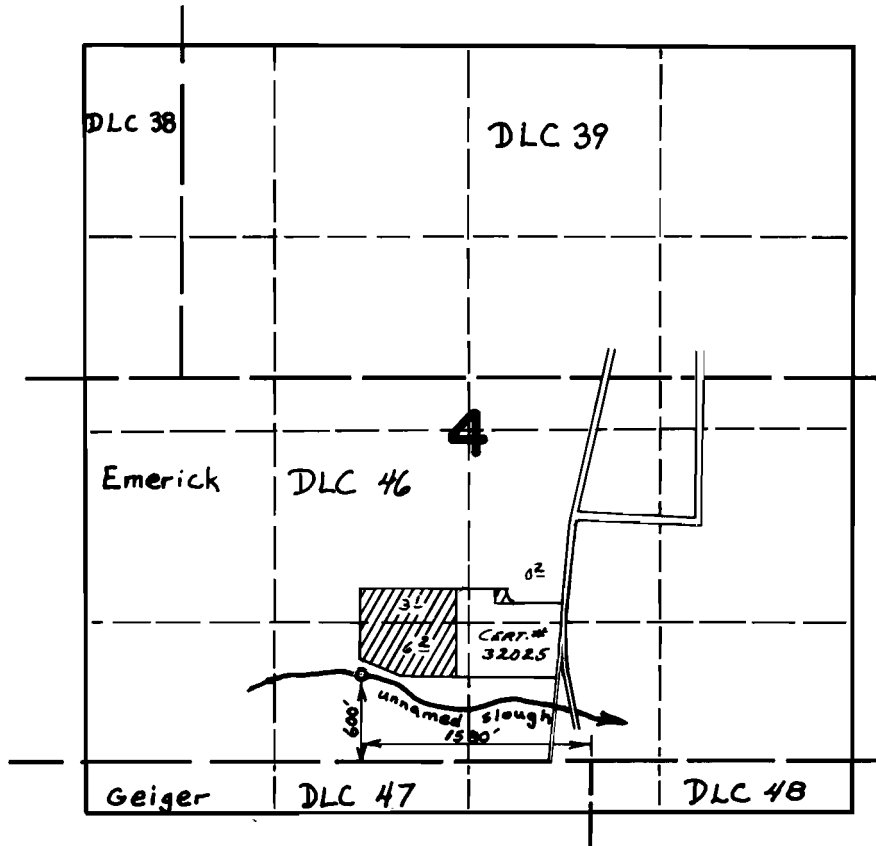

## FINAL PROOF SURVEY UNDER

Application No. 43067 Permit No. 32179...  
IN NAME OF

*Lloyd Duyck*

Surveyed MAY 4 1977, by D. NORBY.....