


T. 35S. R. 3W. W.M.

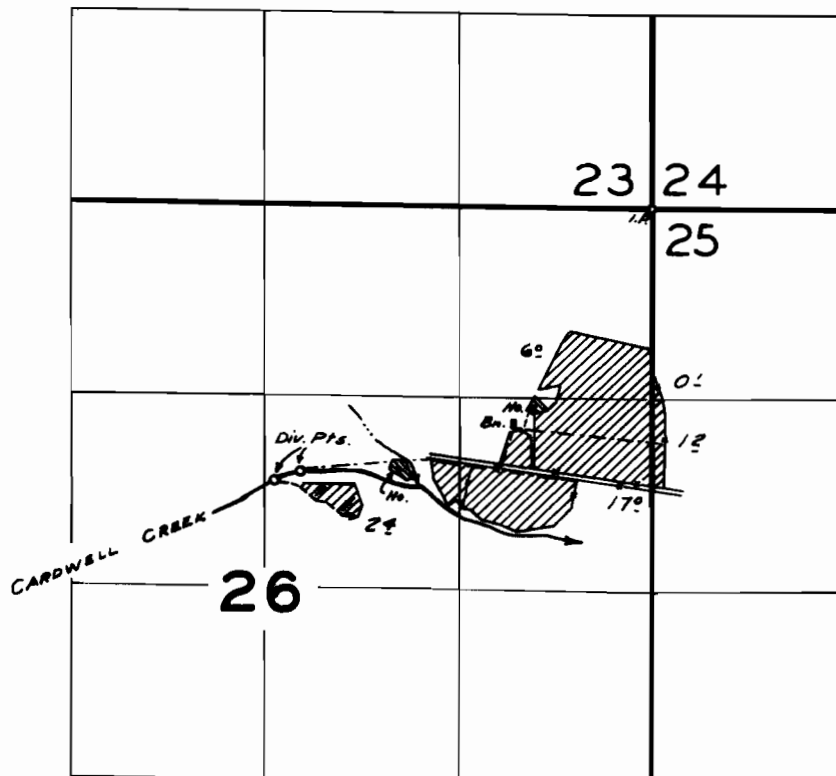

FINAL PROOF SURVEY
UNDER

Application No. 27409 21585
29549 Permit No. 23282....
IN NAME OF

J. W. FITZGERALD

Surveyed 6 April 1960, by *R. H. Jackson*