


T.7S. R.3W.W.M.

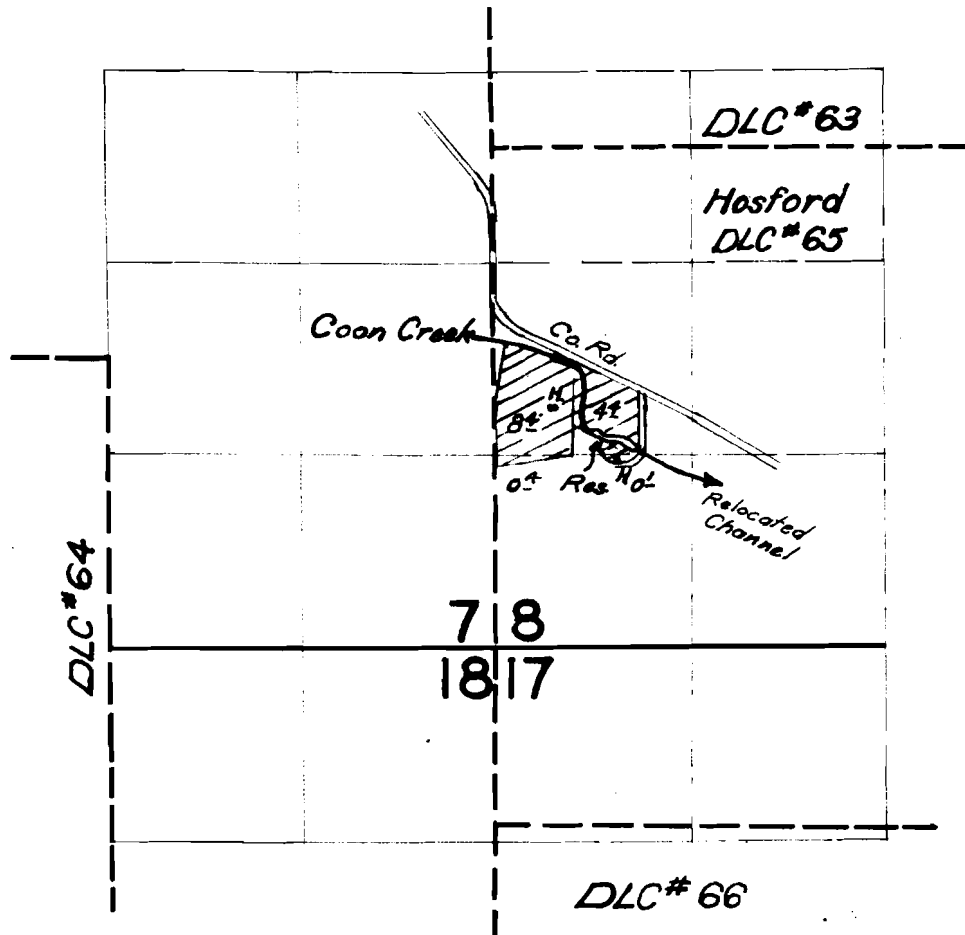

FINAL PROOF SURVEY
UNDER

R-32455 R-2156
Application No. 32456 Permit No. 25632
IN NAME OF

Gurnee Flesher & Al Friske

Surveyed 24 July 1962, by *Carl R. Baker*