


T. 8 S. R. 46 E. W.M.

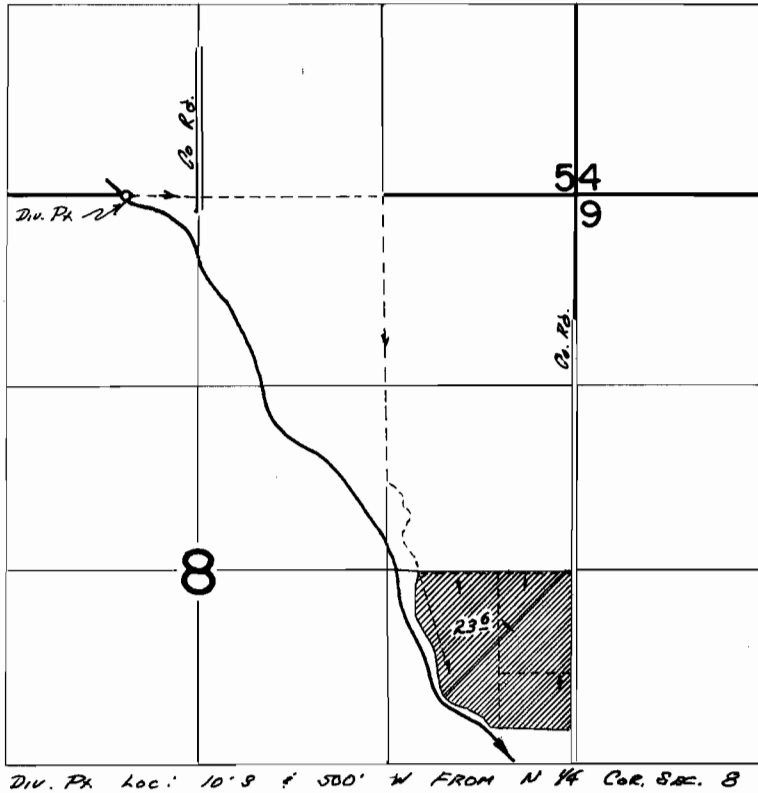

**FINAL PROOF SURVEY**  
UNDER

Application No. 40966 Permit No. 30549  
IN NAME OF

WALTER ROBINSON

Surveyed JUNE 21 1972, by R. P. MUGGER