


T. 7S. R. 38E. W.M.

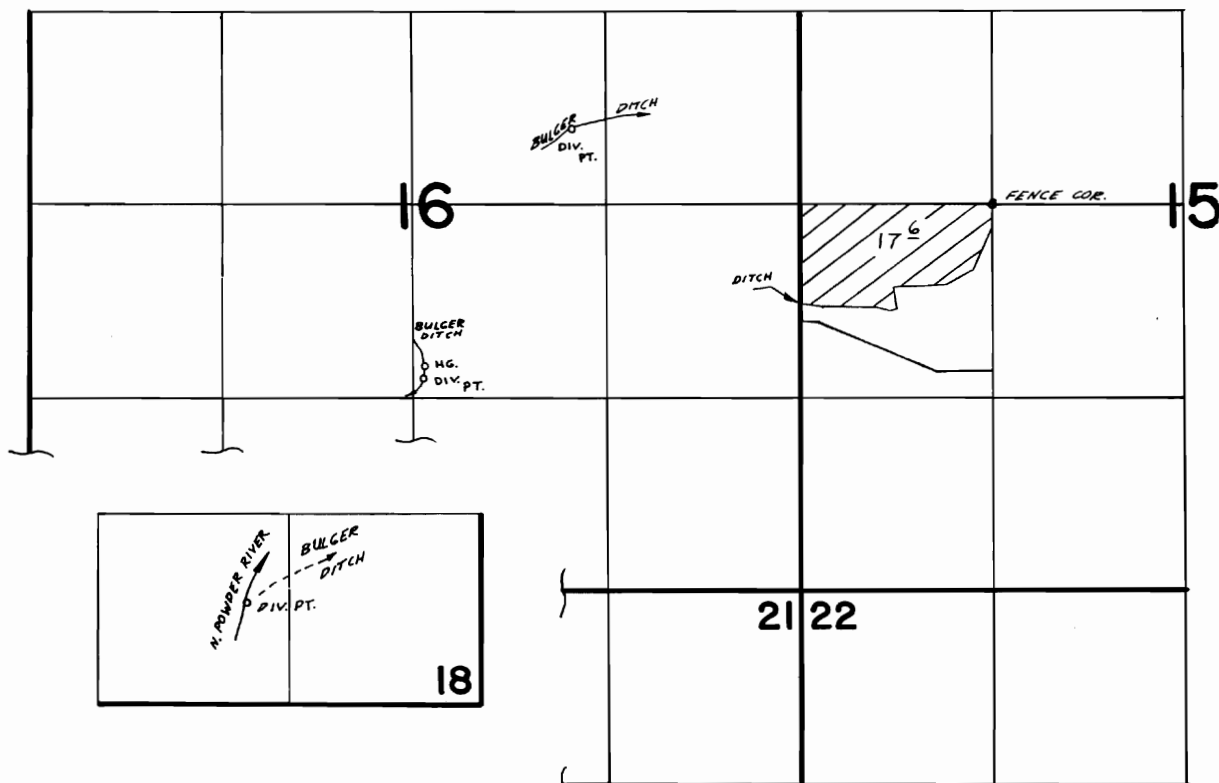

DIV. PT. LOC. 700' N. & 1620' W. FROM SE COR. SEC. 18

FINAL PROOF SURVEY
UNDER

TRANSFER 3853

Application No. **57052** Permit No. **42939**
IN NAME OF

KENNETH BOYER

Surveyed 6-7 1978, by R. BARWIN