


T.10S.,R.4W.,W.M.

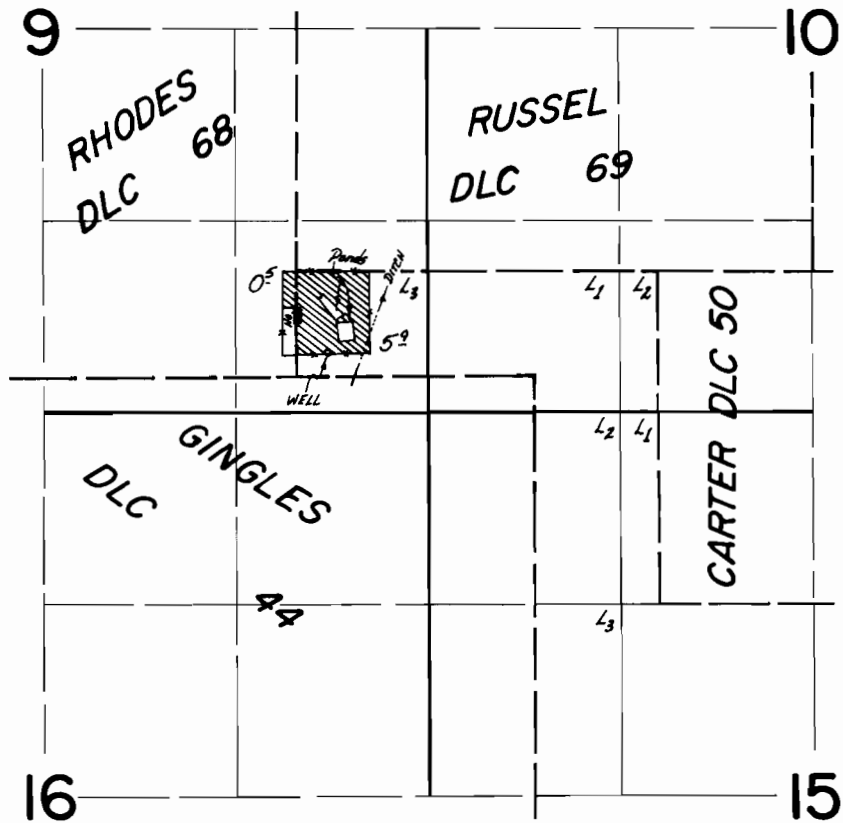

WELL LOCATED 160' N. & 210' E. FROM SE COR. RHODES DLC 68.

FINAL PROOF SURVEY
UNDER

Application No. G-7194 Permit No. G-6625
IN NAME OF

..... JOSEPH D. & NANCY A. ROSA

Surveyed April 28 1977, by L.M. TOLL.....