
T.14S., R.8W., W.M.

SEC. 26

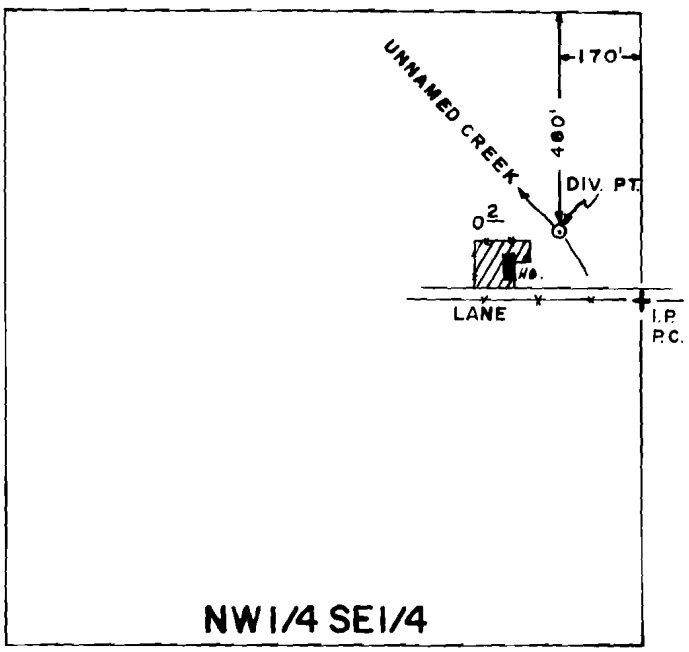

NW1/4 SE1/4

SCALE 1" = 400'

FINAL PROOF SURVEY
UNDER

Application No. 54457 Permit No. 40852
IN NAME OF

JOHN B. & BEVERLY A. BUTTERWORTH

Surveyed SEPT. 28 1979, by S. C. BROWN

PTS 1979A BB