


I, FRED L. DOW OF SUTHERLIN DO HEREBY CERTIFY THAT THIS MAP WAS MADE FROM NOTES TAKEN DURING AN ACTUAL SURVEY MADE BY ME ON APRIL 26th 1955; THAT THE MONUMENT SHOWN ON THIS MAP CONSISTING OF A 1"x36" IRON PIPE IS S63°40' E 1510.0 FEET FROM THE MOST WESTERLY N.W. CORNER OF D.L.C. No. 50 IN SECTION 15, T. 25 S. R. 6 W.W.M, IN DOUGLAS COUNTY, OREGON.

Fred L. Dow

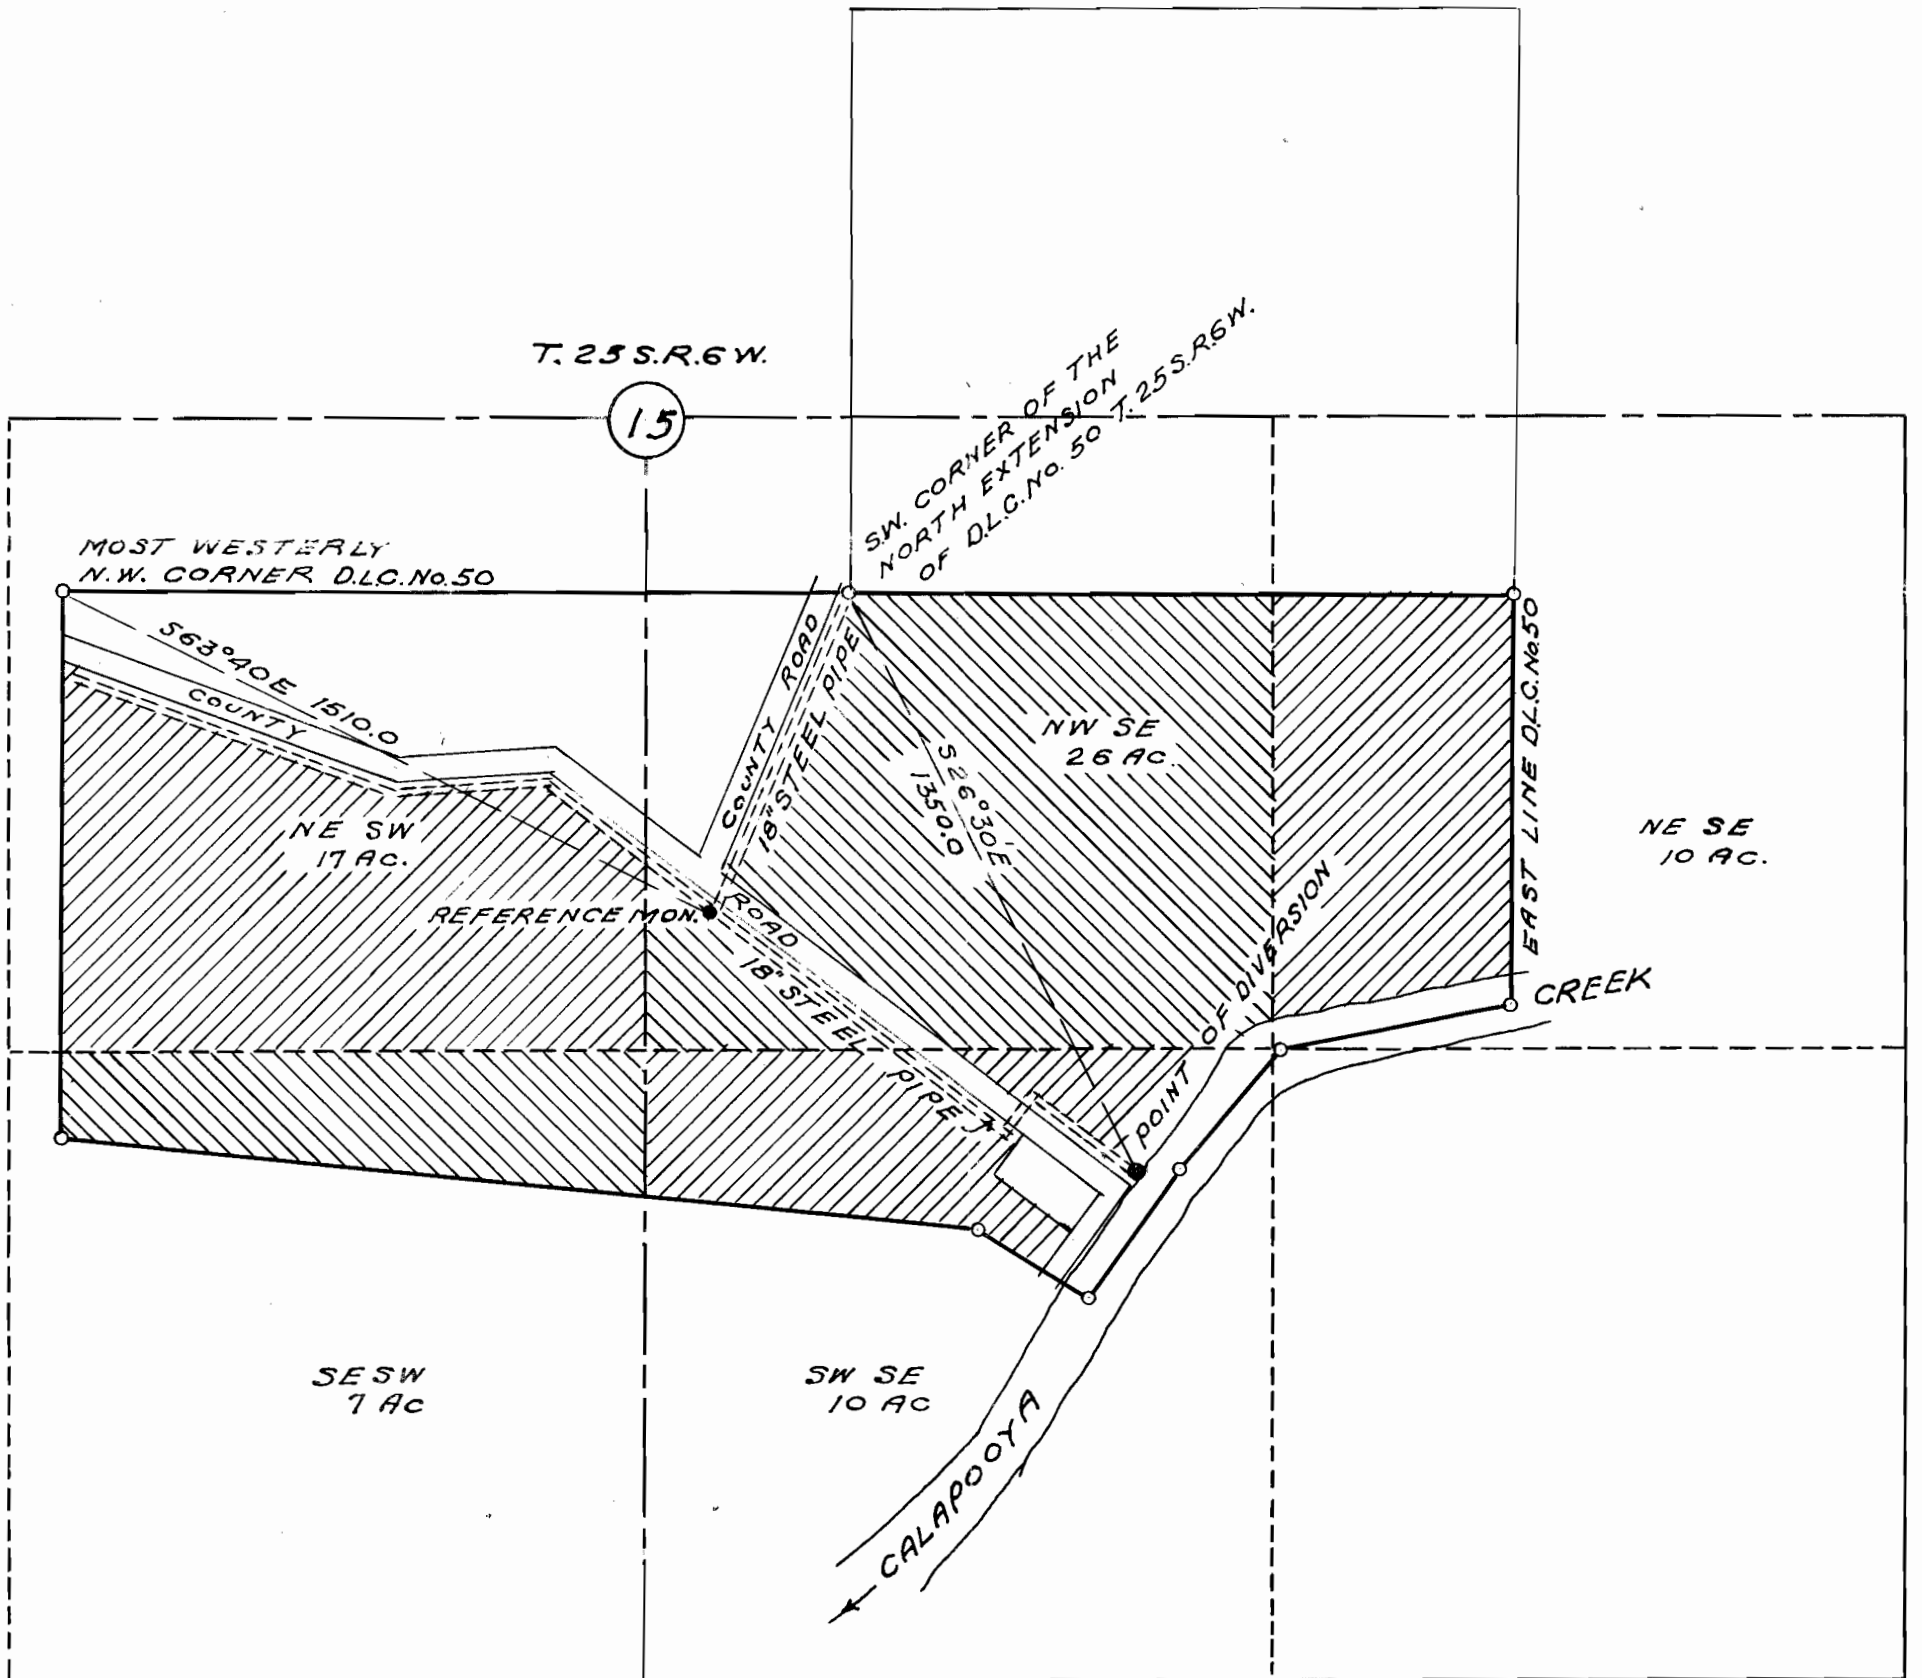

B. F. POUND
1140 GARDEN VALLEY ROAD
ROSEBURG

Registration No. 29956
 Permit No. 29956