


T. 24 S., R. 7 W., W.M.

SEC. 3

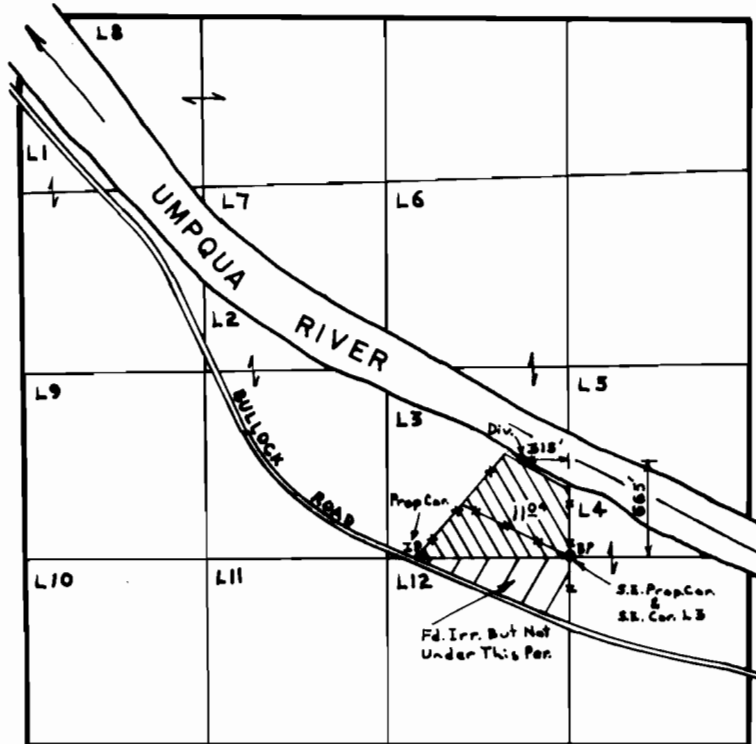

FINAL PROOF SURVEY UNDER

Application No. 50717... Permit No. 38307...
IN NAME OF

ROBERT COWAN

Surveyed MAR. 21. 1978, by D.W. SPARKS...