


T.29 S., R.7 W., W.M.

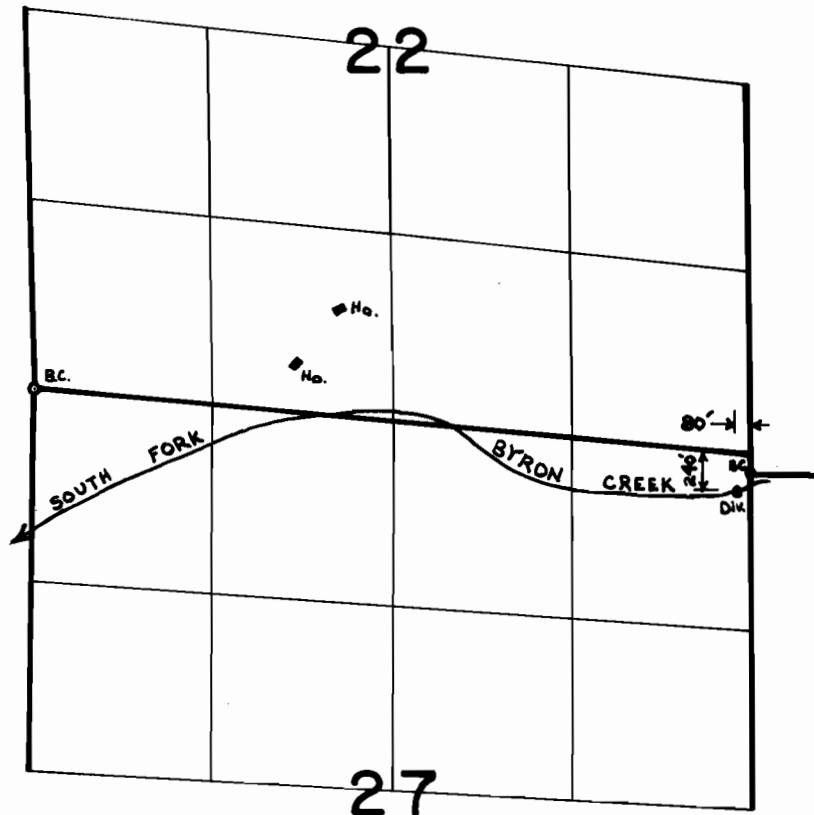

FINAL PROOF SURVEY
UNDER

Application No. 53818 Permit No. 40174
IN NAME OF

JAY M. HAEBERLE & JERRY TOEPKE

Surveyed MAY 24 1978, by D.W. SPARKS