


T.30 S. R.5 W. W.M.

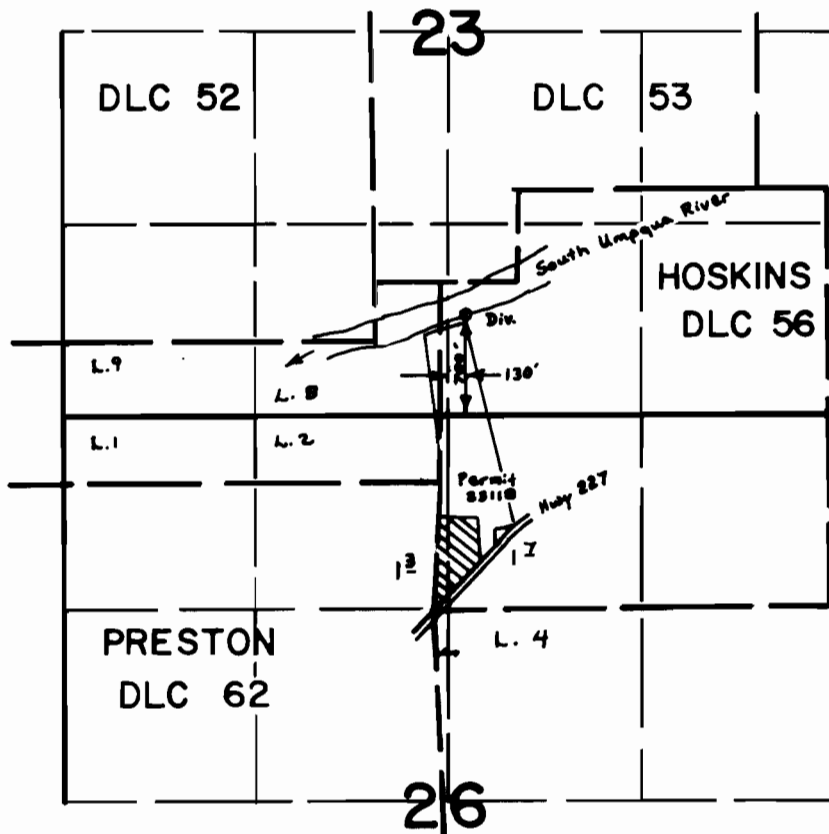

SCALE: 4" = 1 mi.

FINAL PROOF SURVEY
UNDER

Application No. 55288 Permit No. 41634

IN NAME OF

MARVIN COX

Surveyed Feb. 8, 1978, by D.W. Sparks