


T. 29 S., R. 5 W., W.M.

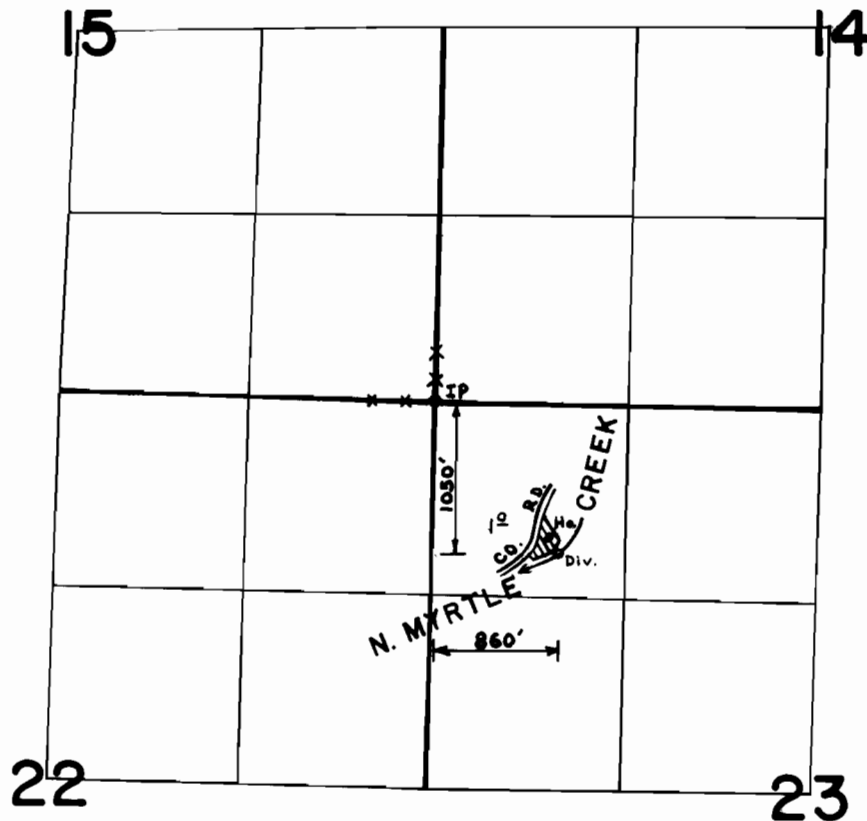

FINAL PROOF SURVEY
UNDER

Application No. 56314 Permit No. 42159
IN NAME OF

Mrs. EDWARD W. THOMAS

Surveyed JULY.26. 1978. by D.W. SPARKS...