


T.29S. R.5W. W.M.

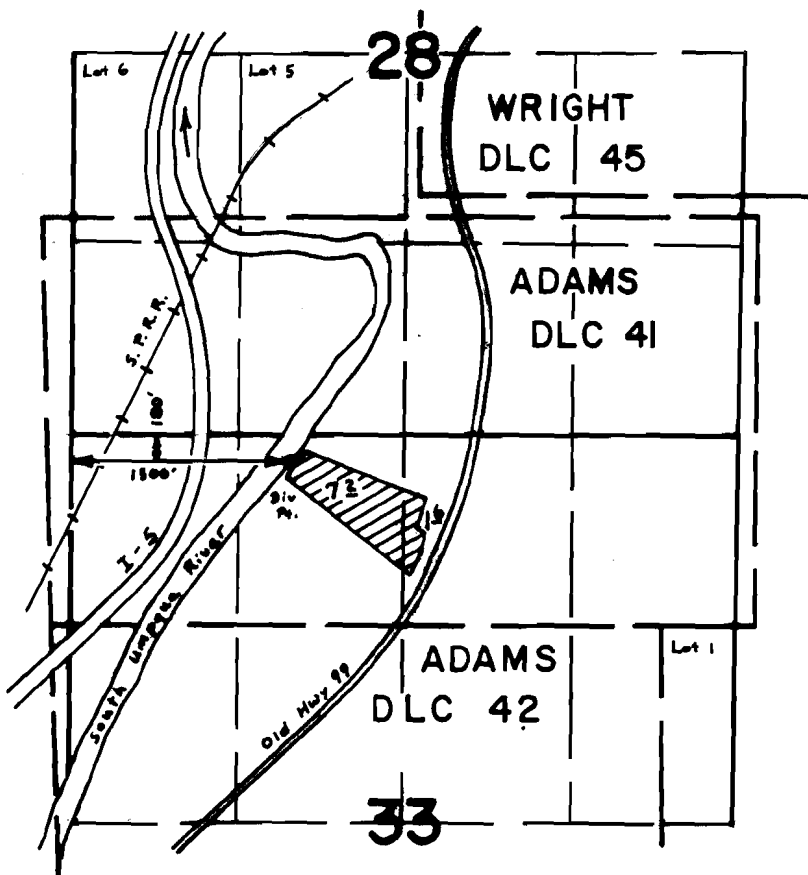

SCALE: 4" = 1 mile

FINAL PROOF SURVEY
UNDER

Application No. 56998 Permit No. 42902
IN NAME OF

KENNETH L. McFARLAND

Surveyed Nov. 7, 1978, by S. Donaldson.