


T. 28 S. R. 4 W. W.M.

Sec. 28

S 1/2 NE 1/4

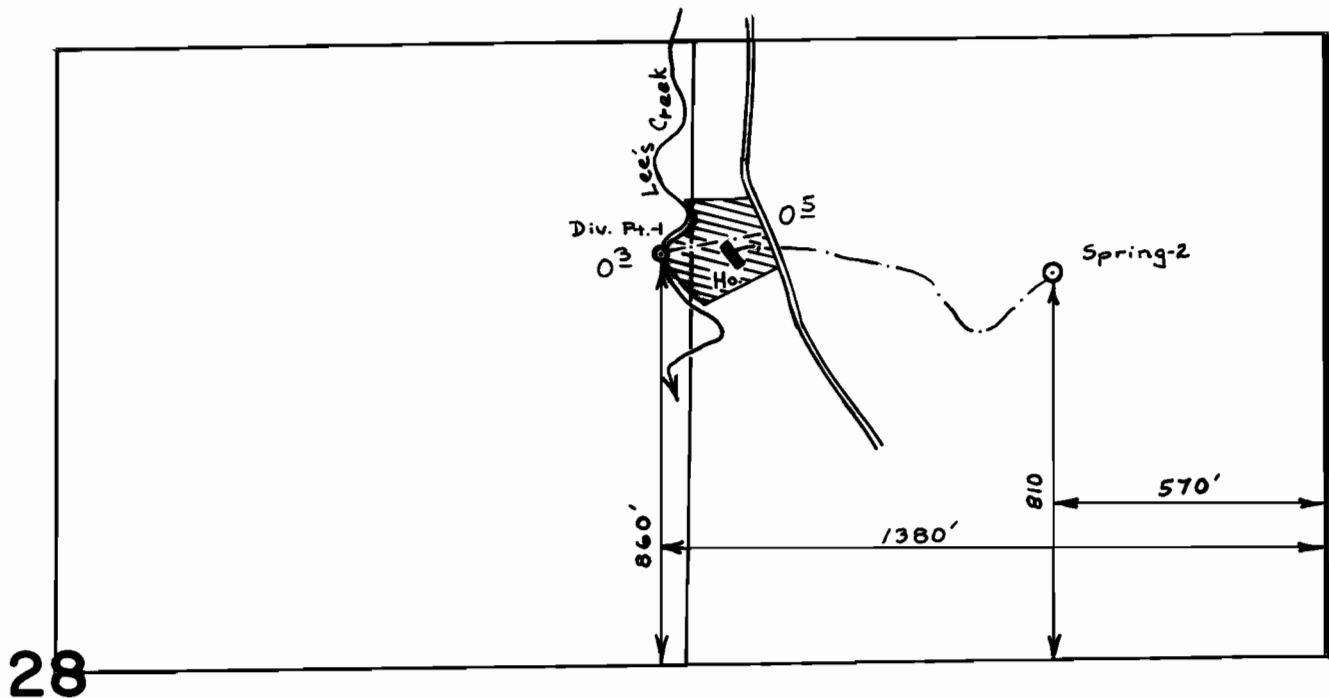

SCALE: 1" = 400'

FINAL PROOF SURVEY
UNDER

Application No. 50961 Permit No. 38469
IN NAME OF

SUZANNE RAINBOW

Surveyed Nov. 9 1978, by S. Donaldson