


# T.24S. R.5W. W.M.

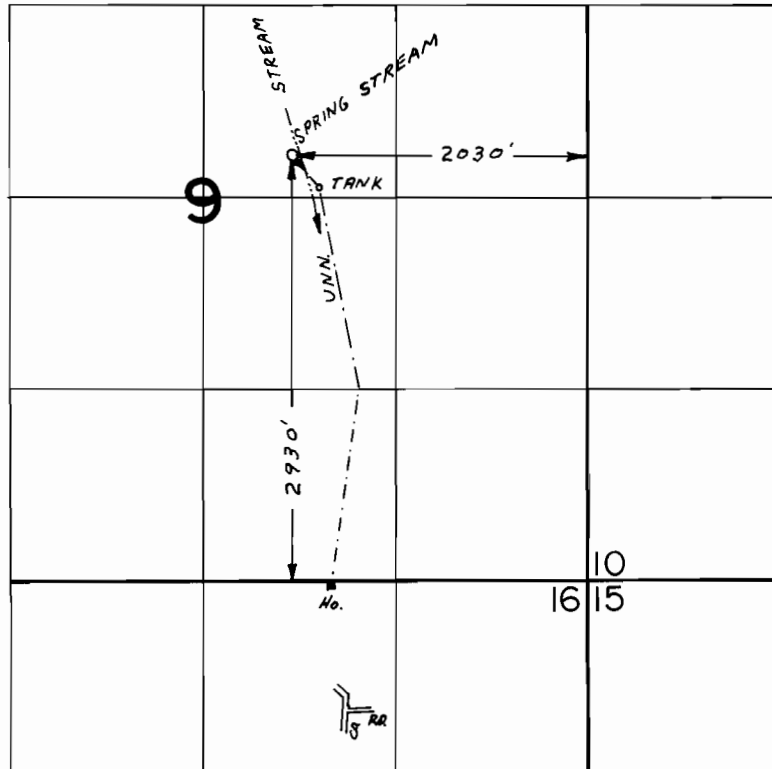

## FINAL PROOF SURVEY UNDER

Application No. 54244 Permit No. 40630  
IN NAME OF

ROBERT G. & DARLENE M. FUGATE

Surveyed AUG. 18. 1976, by L.H. NUNN  
INSPECTION MAY 22, 1976 by D.W. SPARKS