


T. 26 S., R. 7 W., W.M.

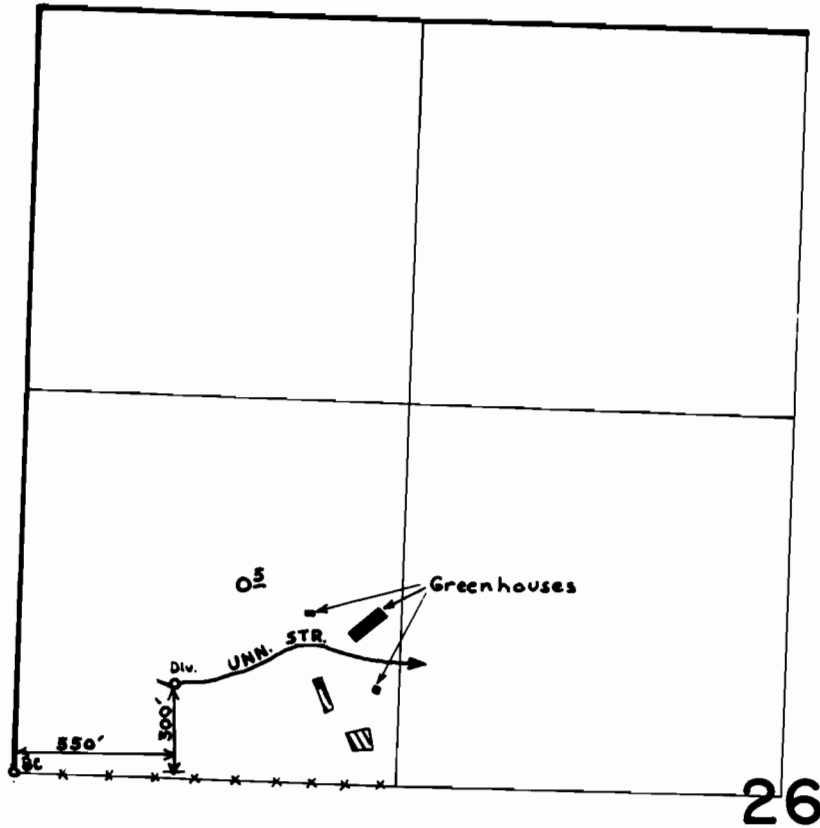

SCALE: 1" = 660'

**FINAL PROOF SURVEY  
UNDER**

Application No. 50826. Permit No. 38374...  
IN NAME OF

**REINALD A. & DORIS I. ESHLEMAN**

Surveyed APR. 10. 1978, by D.W. SPARKS....