


T. 26 S., R. 7 W., W.M.

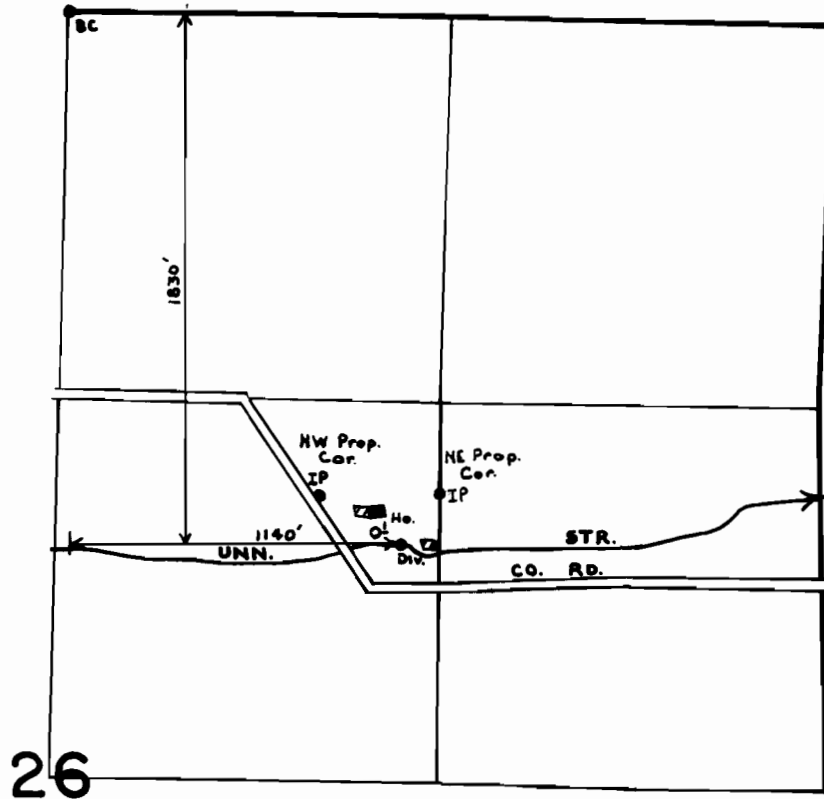

Scale: 1" = 660'

FINAL PROOF SURVEY UNDER

Application No. 50828 Permit No. 38376
IN NAME OF

DONALD D. FAST

Surveyed DEC. 21 1977, by D.W. SPARKS