


T. 28 S. R. 4 W. W.M.

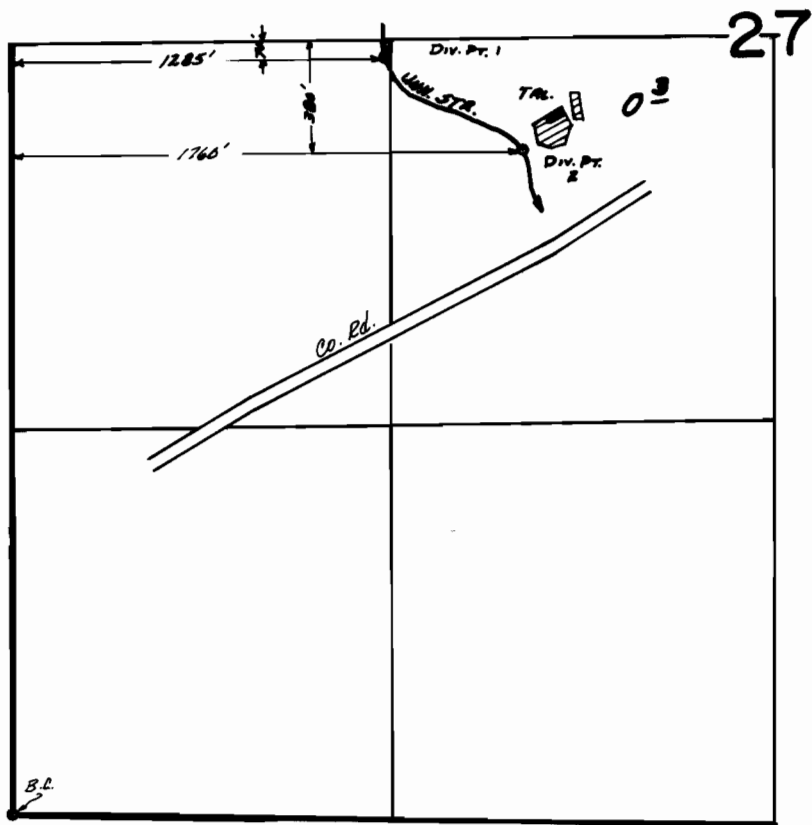

Scale: 1" = 660'

**FINAL PROOF SURVEY**  
UNDER

Application No. 47969 Permit No. 35982  
IN NAME OF

DOVIE LOUDERMILK

Surveyed OCT. 5, 1977, by D.W. SPARKS.