


T. 34 S., R. 1 W., W.M.
SEC. 28

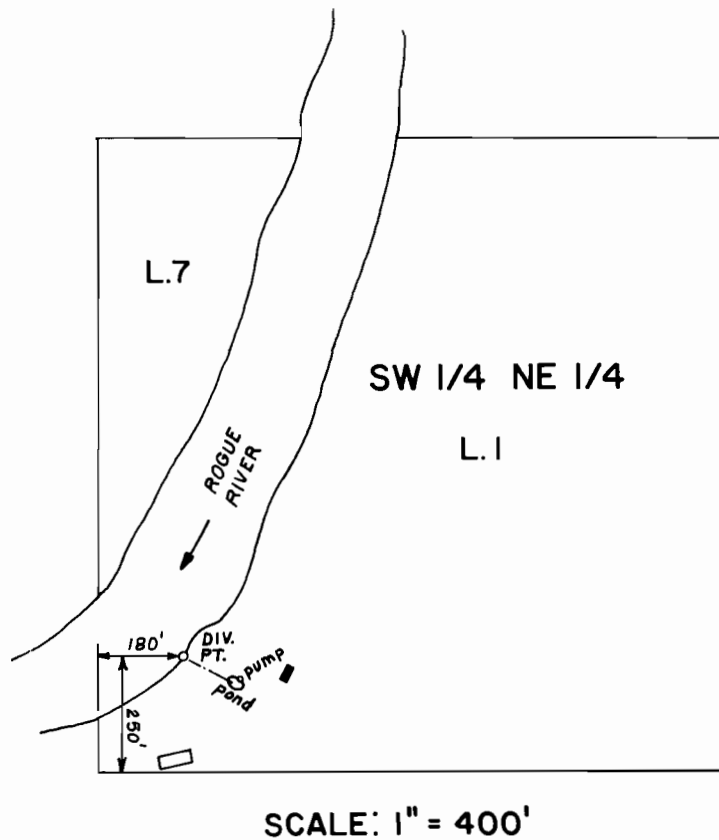

FINAL PROOF SURVEY
UNDER

TRANSFER NO. 3422 & 3423

Application No. Permit No.


IN NAME OF

.....MR. KAY PHILLIP SHUGART.....

Surveyed JULY 12, 1983, by B. S. JAMES....

T.34 S., R.1W., W.M.

SEC. 28

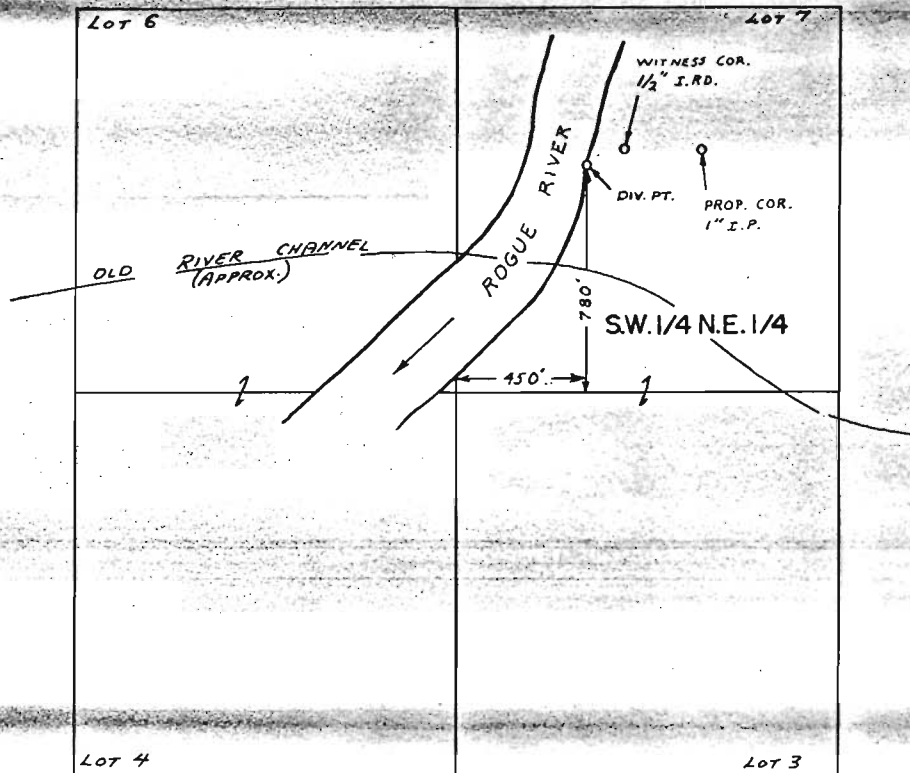

SCALE : 1" = 660 FT.

FINAL PROOF SURVEY
UNDER

Transfer No. ~~3425~~

Transfer No. 3426

Application No. 8726 Permit No. 5695 - Cert. No. 49186
IN NAME OF

TRUMAN DEAN & Z. IDELLE COLLINS

Surveyed AUG. 16 1978 by B. SUND

*This cert. C.I.P.O.D.
approved by order of
Director 10-26-79
and together with
Cert. 48962, Vol. 42
and two orders of
Director of 10-26-69
supersede Cert. 10523, Vol. 10.*