


T. 33 & 34 S., R. 2 W., W.M.

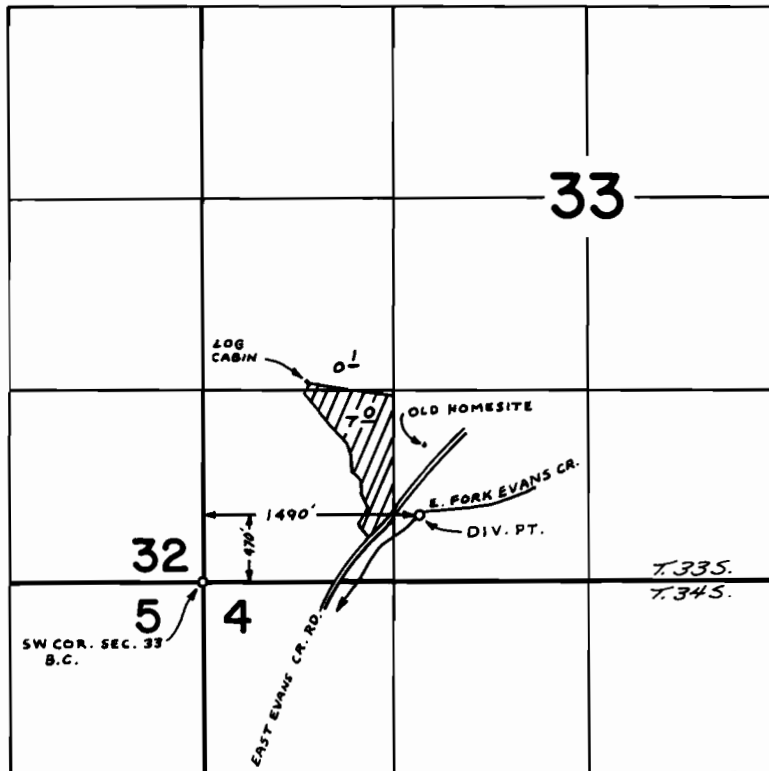

**FINAL PROOF SURVEY
UNDER**

Transfer No. 3367

Application No. 53959 Permit No. 40249
IN NAME OF

GERALDINE S. BRYANT

Surveyed APR. 13 1978, by B. SUND