


T.34S., R.1W., W.M.

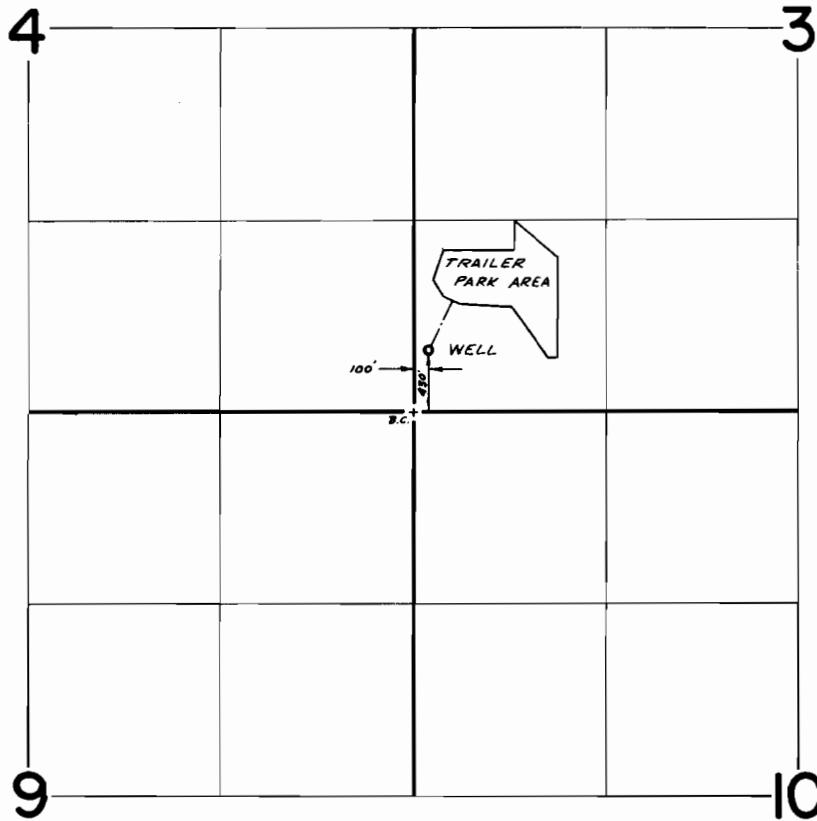

FINAL PROOF SURVEY
UNDER

Application No. G-4097 Permit No. G-3947
IN NAME OF

DONALD W. & ALENE E. FRANCIS

Surveyed Aug. 19 1975, by D. Norby