


T. 33 S., R. 1 W., W.M.

SEC. 36

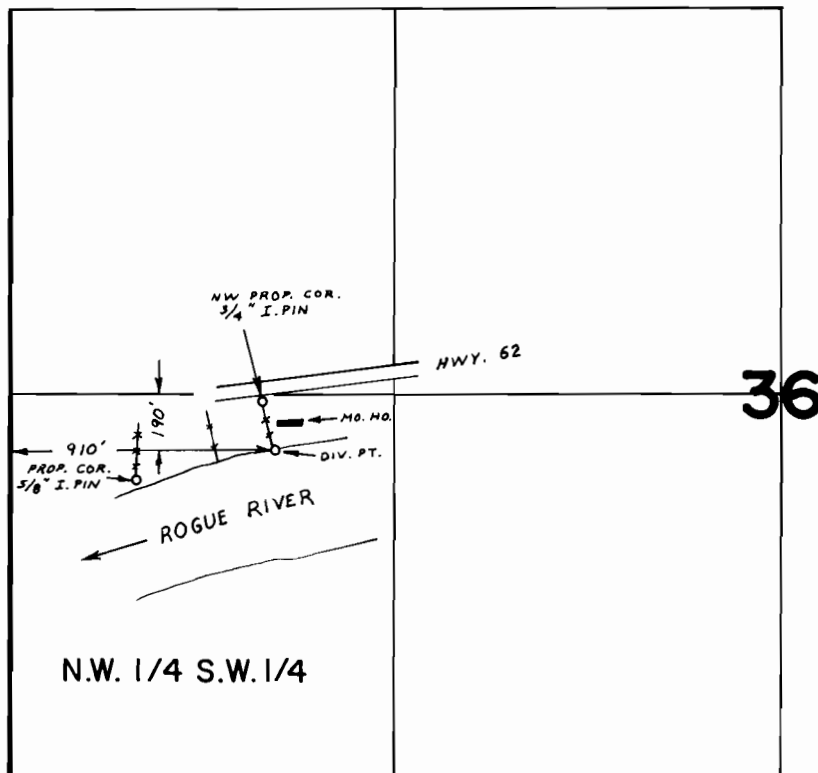

SCALE : 1" = 660 FT.

**FINAL PROOF SURVEY
UNDER**

Application No. 53860 Permit No. 39382
IN NAME OF

EMERSON BROWN

Surveyed AUG. 29 1978 by B. SUND