


T. 27S. R. 15&16E. W.M.

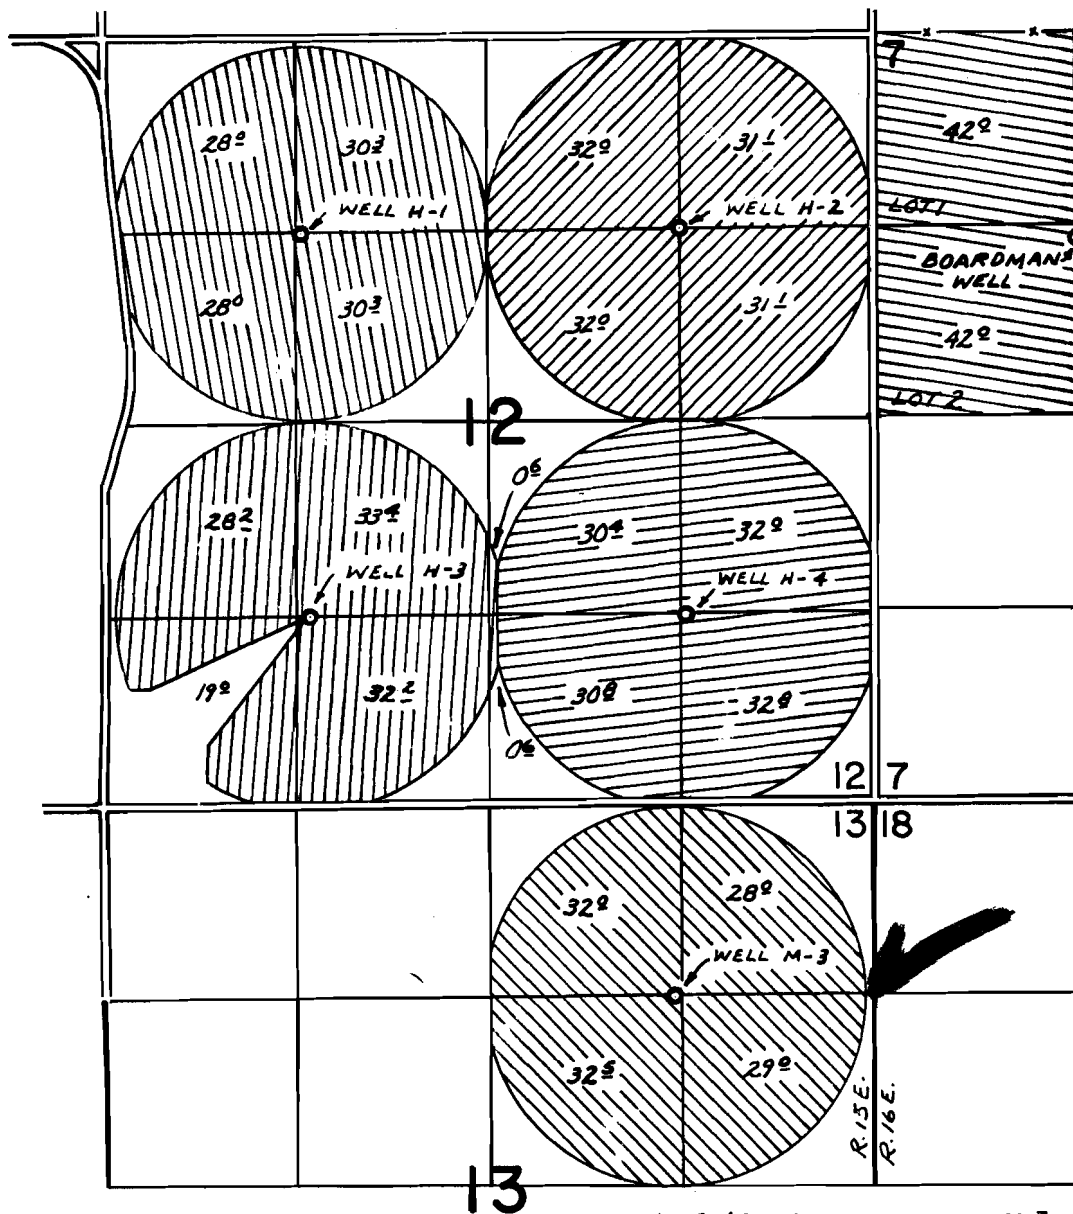

WELLS LOC: BOARDMAN WELL - 1430'S. & 1380'E. FROM N.W. COR. SEC. 7
 WELL H-1 - 1330'S. & 3930' W;
 H-2 - 1330'S. & 1320' W;
 H-3 - 3960'S. & 3860' W;
 H-4 - 3960'S. & 1280' W, ALL FROM N.E. COR. SEC. 12
 M-3 - 1340'S. & 1370' W. FROM N.E. COR. SEC. 13

FINAL PROOF SURVEY

G-6756
 G-8786
 G-8787
 G-8773
 G-8794
 G-8775

G-6007
 G-8068
 G-8069
 G-8072
 G-8073
 G-8074



Application No. G-8775 Permit No. G-8074

IN NAME OF

.....DOWERS FARMS, INC.

Surveyed AUG. 29, 1979, by S. P. APPELEGATE